



**NOTES:**  
 STRUCTURE SHOWN IN YELLOW FIRM LINE ARE SANCTIONED & SHALL BE CONSTRUCTED.  
 STRUCTURE SHOWN IN YELLOW DOTTED LINE ARE SANCTIONED BUT SHALL NOT BE CONSTRUCTED.  
 STRUCTURE SHOWN IN RED HATCH ARE NOT SANCTIONED BUT PROPOSED FOR CONSTRUCTION.


THIS DRAWING IS A PRIVATE AND CONFIDENTIAL COMMUNICATION AND THE PROPERTY OF MANIRAMKA AND ASSOCIATES AND MUST NOT BE COPIED OR LENT WITHOUT THE CONSENT OF MANIRAMKA AND ASSOCIATES.  
**NOTES:**  
 FOR DOOR AND WINDOW SCHEDULE REFER TO NO. - FORTUNE HEIGHTS/BSR/BLK-A&K

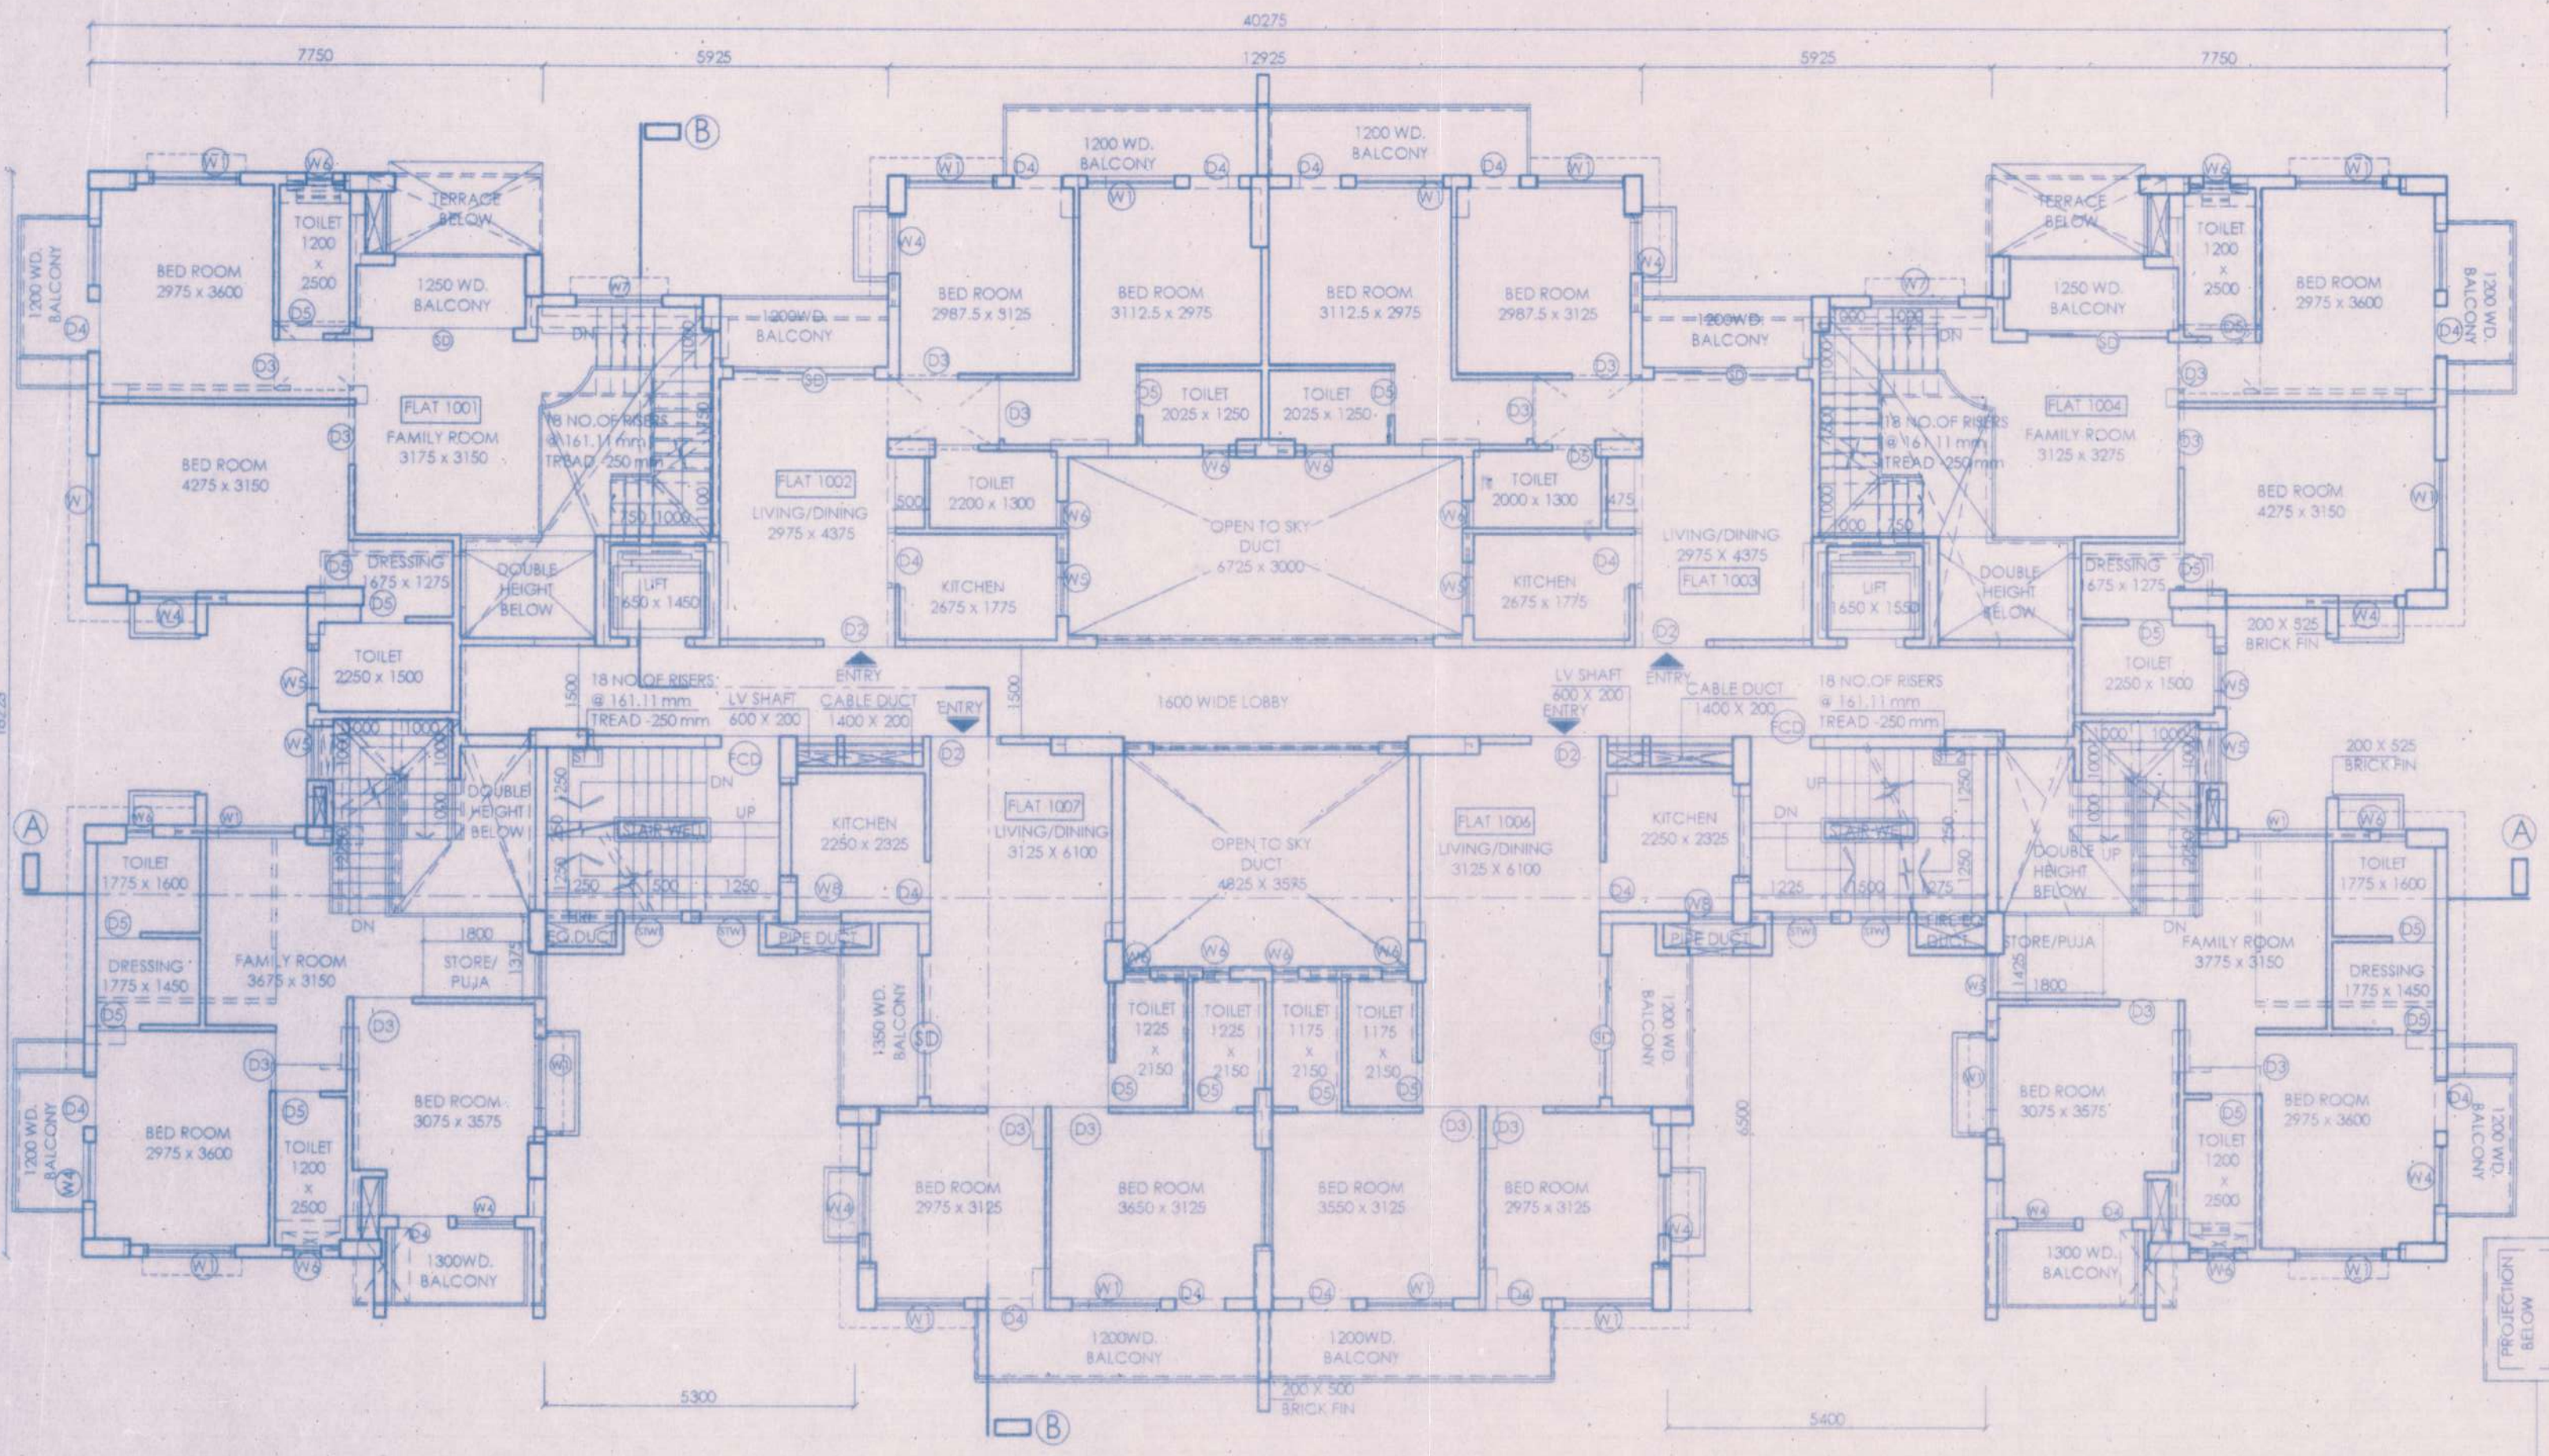

11TH FLOOR PLAN

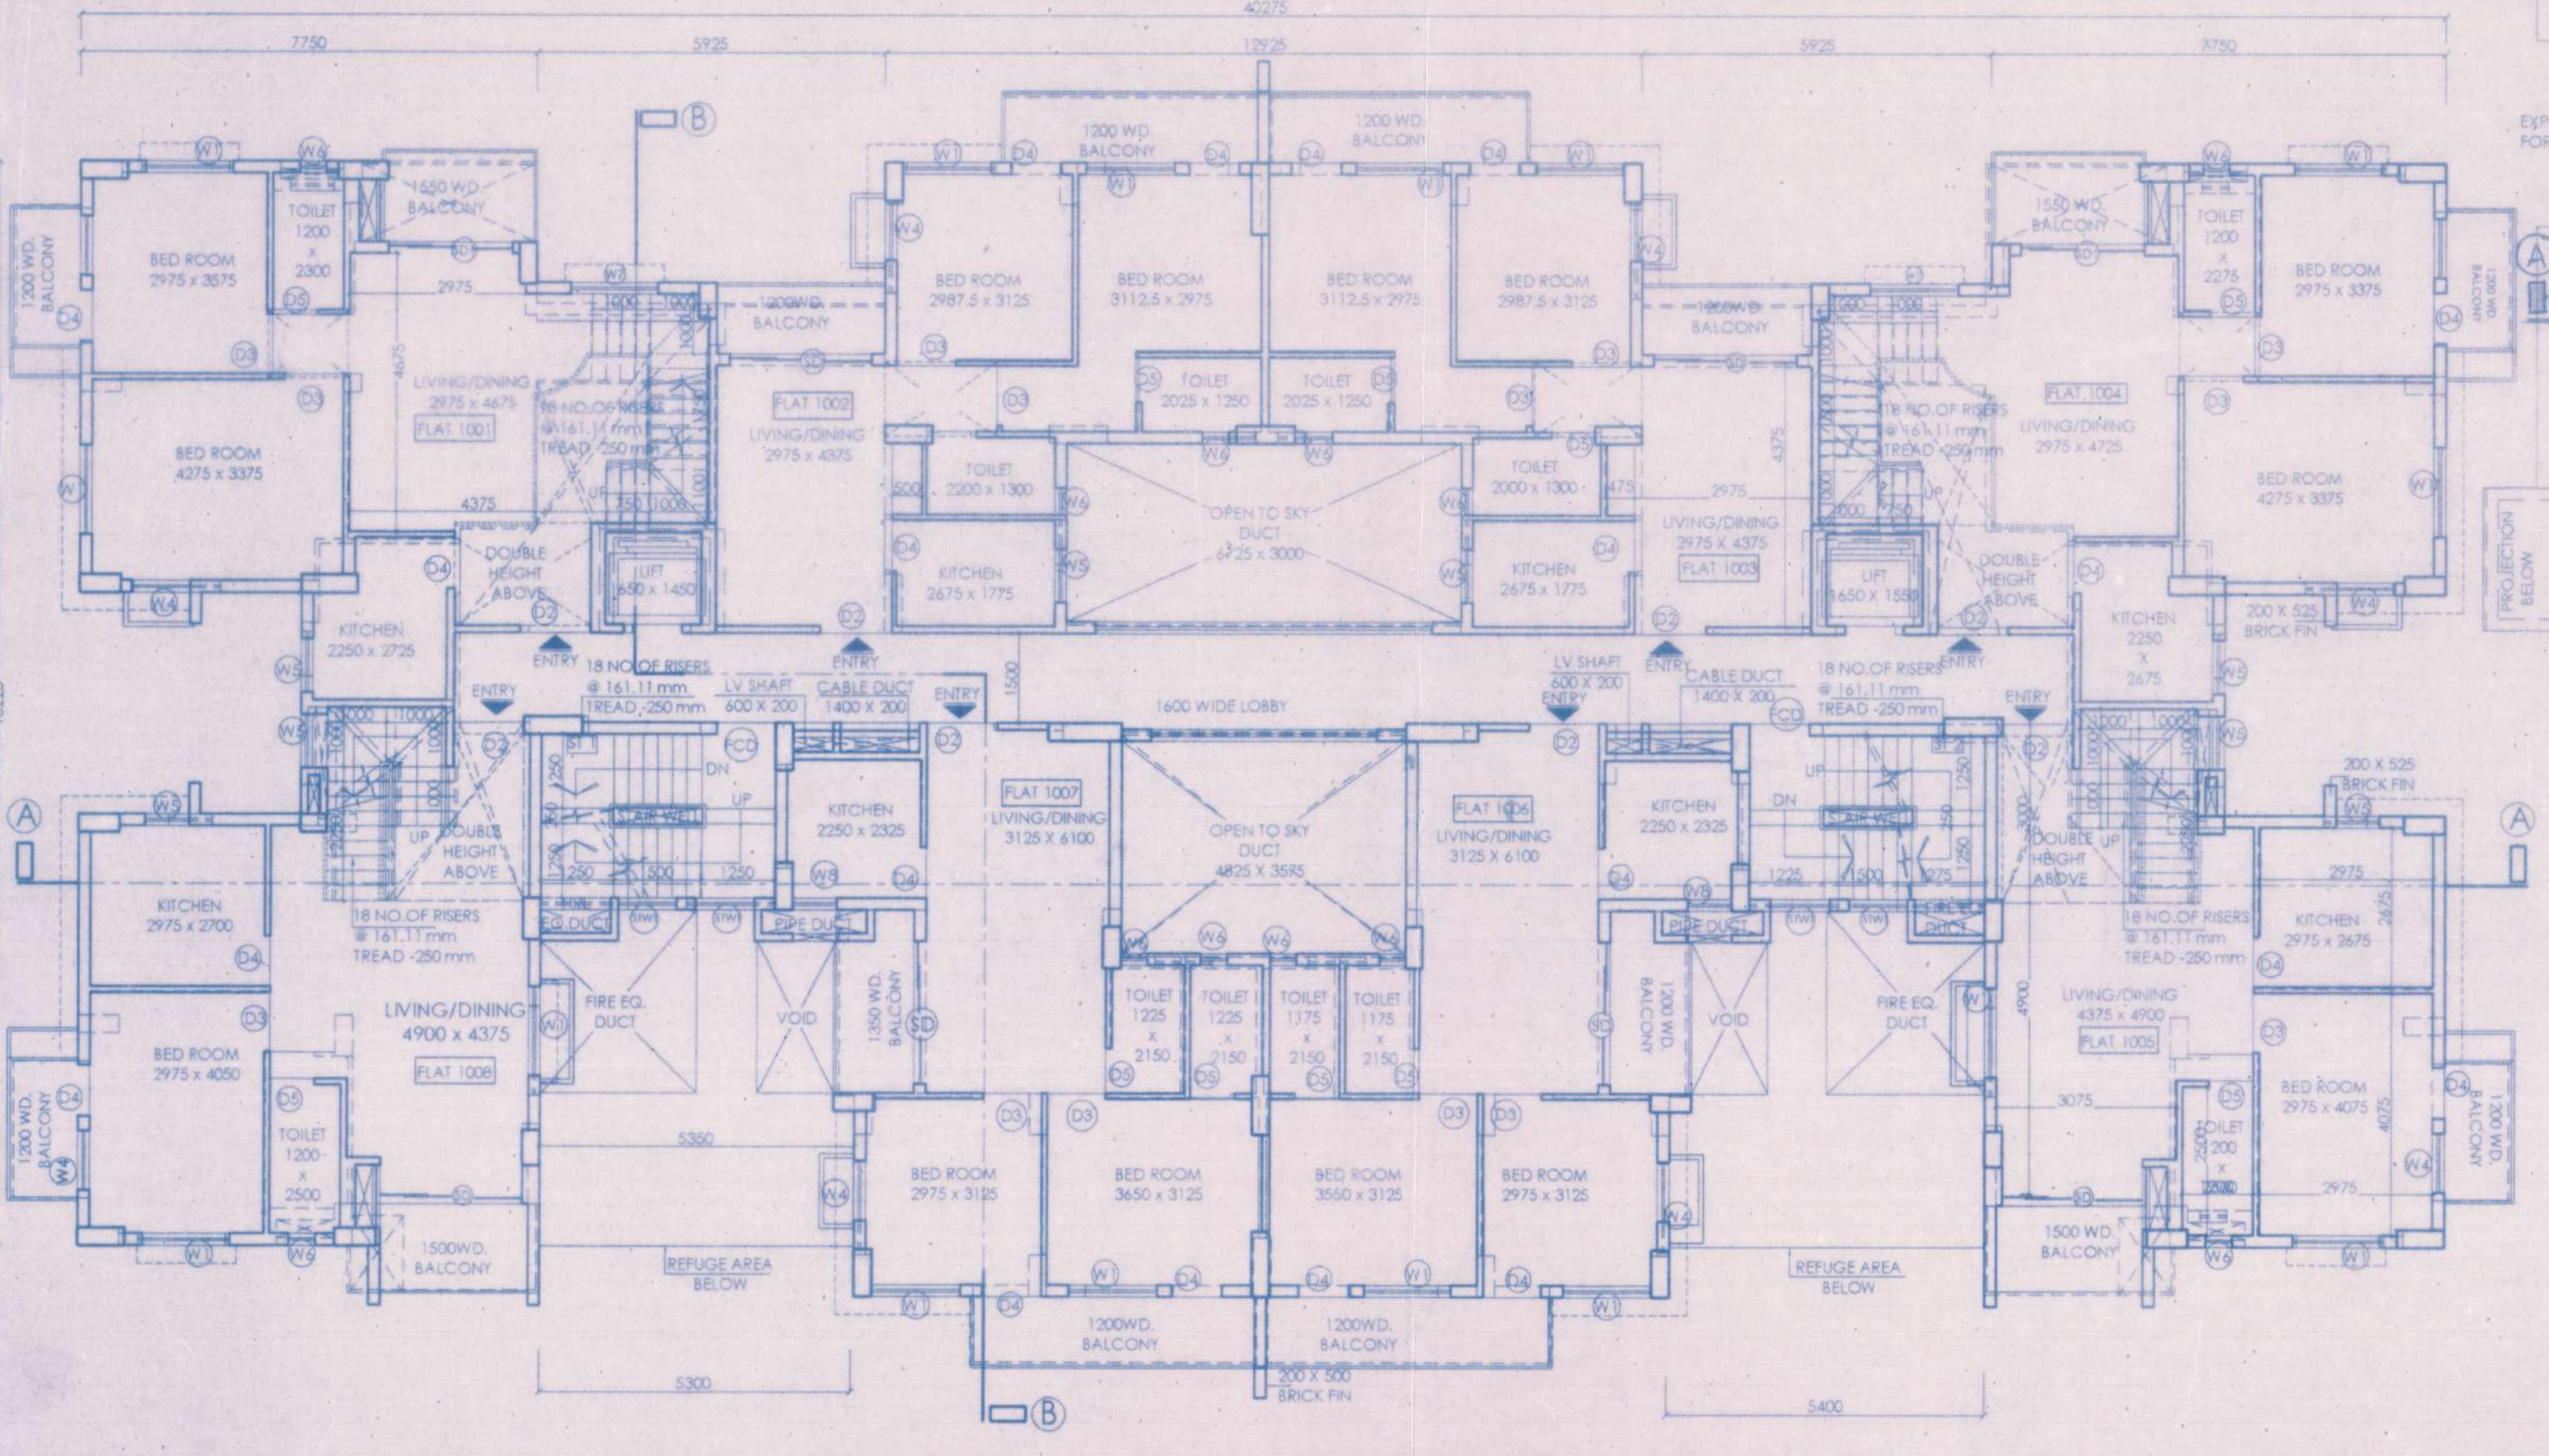

10TH FLOOR PLAN

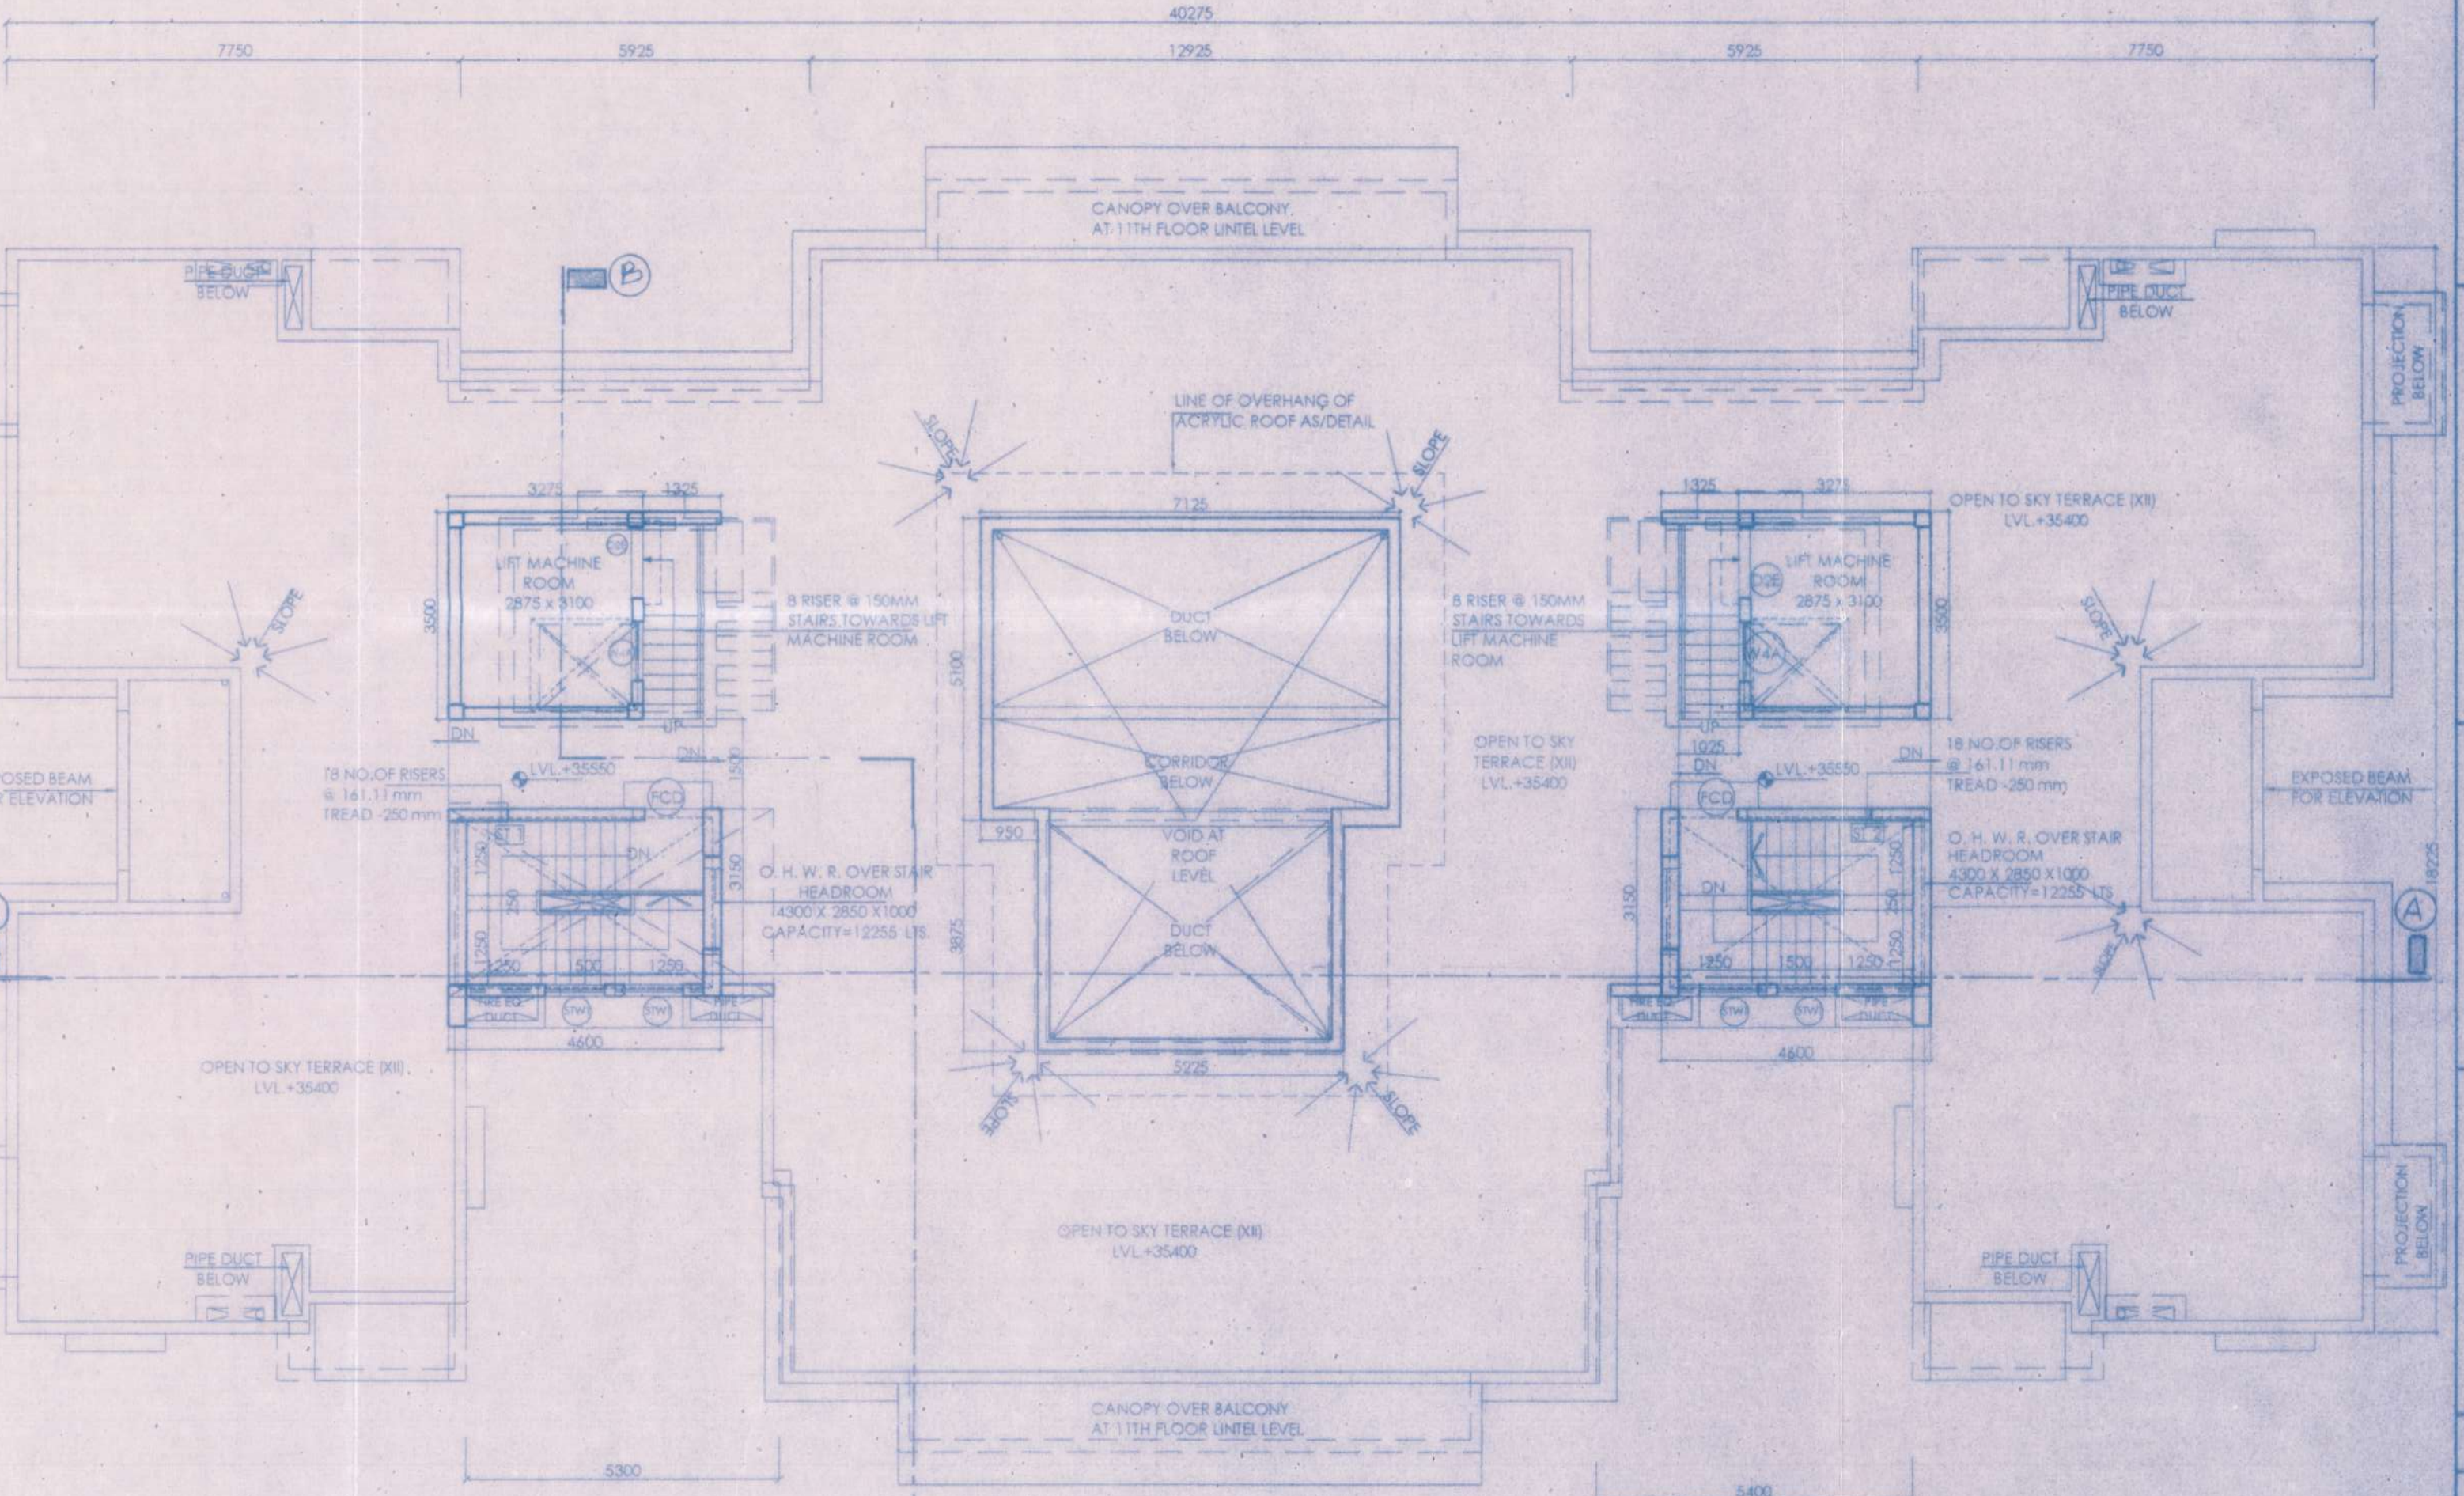

ROOF PLAN

PLAN PERMITTED  
 24.02.2016  
 Prodan  
 Paschim Khilkapur Gram Panchayat  
 Barasat Block-I, North 24-Pgs.

SI.No-53  
 24-11/8/16

**CERTIFICATE OF ARCHITECT**  
 I DO HEREBY CONFIRM AND CERTIFY WITH FULL RESPONSIBILITY THAT THE BUILDING PLAN HAS BEEN PREPARED BY ME KEEPING THE PROVISIONS OF B.C.O. OF INDIA AND CERTIFY THAT IT IS SAFE AND STABLE IN ALL RESPECT

Sunil Maniramka  
 SUNIL MANIRAMKA (B.Arch.)  
 Consulting Architect  
 Council of Architecture (Regn. No. CA/83/16658)

**CERTIFICATE OF ENGINEER**  
 THE STRUCTURAL DESIGN AND DRAWINGS OF BOTH FOUNDATION AND SUPER STRUCTURE OF THE BUILDING HAS BEEN MADE BY ME CONSIDERING THE SOIL TEST REPORT SUBMITTED BY GEOCON, 55, BADAN ROY LANE, BELLAHATA, KOLKATA - 700010, AND ALSO CONSIDERING ALL POSSIBLE LOADS, SEISMIC LOAD AND THE MOMENTS GENERATED BY THE PROPOSED STRUCTURE AS PER BIS & THE NATIONAL BUILDING CODE OF INDIA & CERTIFIED THAT IT IS SAFE & STABLE IN ALL RESPECT & THESE PROVISIONS SHALL BE ADHERED TO DURING THE CONSTRUCTION.

Chandi Prasad Khanna  
 CHANDI PRASAD KHANNA  
 BE (CIVIL), ME (STRUCT.), MIE (INDIA)  
 ESE - 1/2

**CERTIFICATE OF GEO-TECHNICAL ENGINEER**  
 THIS IS TO CERTIFY THAT THE SOIL TEST HAS BEEN PERFORMED BY ME FOR THIS PROJECT

Prasanta Kumar Ghosh  
 Prasanta Kumar Ghosh  
 Geotechnical Engineer  
 B.E.M.Tech. M.I.G.S.I.M-3583

**CERTIFICATE OF OWNER**  
 THIS IS TO CERTIFY THAT I SHALL NOT ON A LATER DATE MAKE ANY ADDITION OR ALTERATION TO THE PLAN. IT IS CERTIFIED THAT I HAVE GONE THROUGH THE B.C.O. OF INDIA AND ALSO ABIDE BY THOSE RULES DURING AND AFTER CONSTRUCTION OF BUILDING

Fortune Park Housing Projects (P) Ltd.  
 Director

**PROJECT**  
 REVISED PLAN OF G+11 (35.4 M. HT.) STORED BUILDING NOS. (A,B,C), J,K,L,M,N, O, H, F, G & CLUB) AND G+7 (25.8M HT.) STORED BUILDING NO.-E, AT 168 KRISHNANAGAR ROAD (NH-34); R.S./L.R. DAGANO 1576, 1577, 1578, 1579, 1581, 1589, 1590, 1591, 1592, 1593, 1594, 1599, 1600, 1600/1754, 1600/1755, 1578/1752, 1578/1753, 1579/1752 AND 1599/1754 UNDER L.R.KHATIAN NO.1772 UNDER MOUZA: MOYNAGADJ, J.L.NO. 06 IN SANSD NO-VII UNDER P.O.: NOAPARA, P.S -BARASAT, NORTH 24 PARGANAS UNDER PASCHIM KHILKAPUR GRAM PANCHAYAT, WEST BENGAL. PREVIOUS SANCTIONED S.L. NO.- 64, DATED ON- 27.02.2014

**SANCTION DRAWING**  
 BLOCK- A & K  
 10TH FLOOR PLAN, 11TH FLOOR PLAN AND ROOF PLAN  
 STRUCTURAL CONSULTANTS : Mr. Chandi Prasad Khanna  
 BE (CIVIL), ME (STRUCT.), MIE (INDIA). SHEET NO. 04  
 DATE : 30.05.16 SCALE : 1:100 DEALT : MAYURI DRG.NO. - FORTUNE HEIGHTS/BSR/BLK-A&K/04  
 ARCHITECTS : MANIRAMKA AND ASSOCIATES NORTH AS/SITE  
 74B, A. J. C. BOSE ROAD, KOLKATA-700 016 RO  
 PHONE : (033) 2217 8329  
 E mail: maniramka@gmail.com