

**NOTES :-**

- 1. ALL DIMENSIONS ARE IN MM.
- 2. COPY OF FOUNDATION PLAN SHOULD NOT GO BEYOND THE DEPTH OF CONSTRUCTION OF GROUND. ALL SURF OF FOUNDATION SHALL BE IN THE LINE OF CONSTRUCTION OF GROUND.
- 3. EXTERNAL WALLS ARE 200MM AND INTERNAL WALLS 200MM THICK UNLESS AS SHOWN IN THE DRAWING.
- 4. ALL DIMENSIONS ARE IN MM.
- 5. ALL DIMENSIONS ARE IN MM.
- 6. ALL DIMENSIONS ARE IN MM.

1. WE DO HEREBY CERTIFY THAT THE DESIGN AND CONSTRUCTION OF THE STRUCTURE SHALL BE IN ACCORDANCE WITH THE PROVISIONS OF THE BUILDING REGULATIONS, 1973 AND THE BUILDING ACT, 1986.

2. WE SHALL FOLLOW THE INSTRUCTIONS OF ARCHITECT & E.E. DURING CONSTRUCTION.

3. MATERIALS AND WORKMANSHIP SHALL BE AS PER THE SPECIFICATIONS AND STANDARDS MENTIONED IN THE DRAWING.

4. ALL DIMENSIONS ARE IN MM.

5. ALL DIMENSIONS ARE IN MM.

6. ALL DIMENSIONS ARE IN MM.

7. ALL DIMENSIONS ARE IN MM.

8. ALL DIMENSIONS ARE IN MM.

9. ALL DIMENSIONS ARE IN MM.

10. ALL DIMENSIONS ARE IN MM.

11. ALL DIMENSIONS ARE IN MM.

12. ALL DIMENSIONS ARE IN MM.

**SIGNATURE OF ARCHITECT**  
MR. UTPAL SANTRA  
ENROLLMENT NO. : ST/1999/000011

**CERTIFICATE OF ARCHITECT**  
I HEREBY CERTIFY THAT THE DESIGN AND CONSTRUCTION OF THE STRUCTURE SHALL BE IN ACCORDANCE WITH THE PROVISIONS OF THE BUILDING REGULATIONS, 1973 AND THE BUILDING ACT, 1986.

**SIGNATURE OF STRUCTURAL CIVIL ENGINEER**  
MR. UTPAL SANTRA  
ENROLLMENT NO. : ST/1999/000011

**CERTIFICATE OF STRUCTURAL CIVIL ENGINEER**  
I HEREBY CERTIFY THAT THE DESIGN AND CONSTRUCTION OF THE STRUCTURE SHALL BE IN ACCORDANCE WITH THE PROVISIONS OF THE BUILDING REGULATIONS, 1973 AND THE BUILDING ACT, 1986.

**SIGNATURE OF ARCHITECT**  
MR. UTPAL SANTRA  
ENROLLMENT NO. : ST/1999/000011


**CERTIFICATE OF ARCHITECT**  
I HEREBY CERTIFY THAT THE DESIGN AND CONSTRUCTION OF THE STRUCTURE SHALL BE IN ACCORDANCE WITH THE PROVISIONS OF THE BUILDING REGULATIONS, 1973 AND THE BUILDING ACT, 1986.

**SIGNATURE OF STRUCTURAL CIVIL ENGINEER**  
MR. UTPAL SANTRA  
ENROLLMENT NO. : ST/1999/000011

**CERTIFICATE OF STRUCTURAL CIVIL ENGINEER**  
I HEREBY CERTIFY THAT THE DESIGN AND CONSTRUCTION OF THE STRUCTURE SHALL BE IN ACCORDANCE WITH THE PROVISIONS OF THE BUILDING REGULATIONS, 1973 AND THE BUILDING ACT, 1986.

**SIGNATURE OF ARCHITECT**  
MR. UTPAL SANTRA  
ENROLLMENT NO. : ST/1999/000011

**CERTIFICATE OF ARCHITECT**  
I HEREBY CERTIFY THAT THE DESIGN AND CONSTRUCTION OF THE STRUCTURE SHALL BE IN ACCORDANCE WITH THE PROVISIONS OF THE BUILDING REGULATIONS, 1973 AND THE BUILDING ACT, 1986.

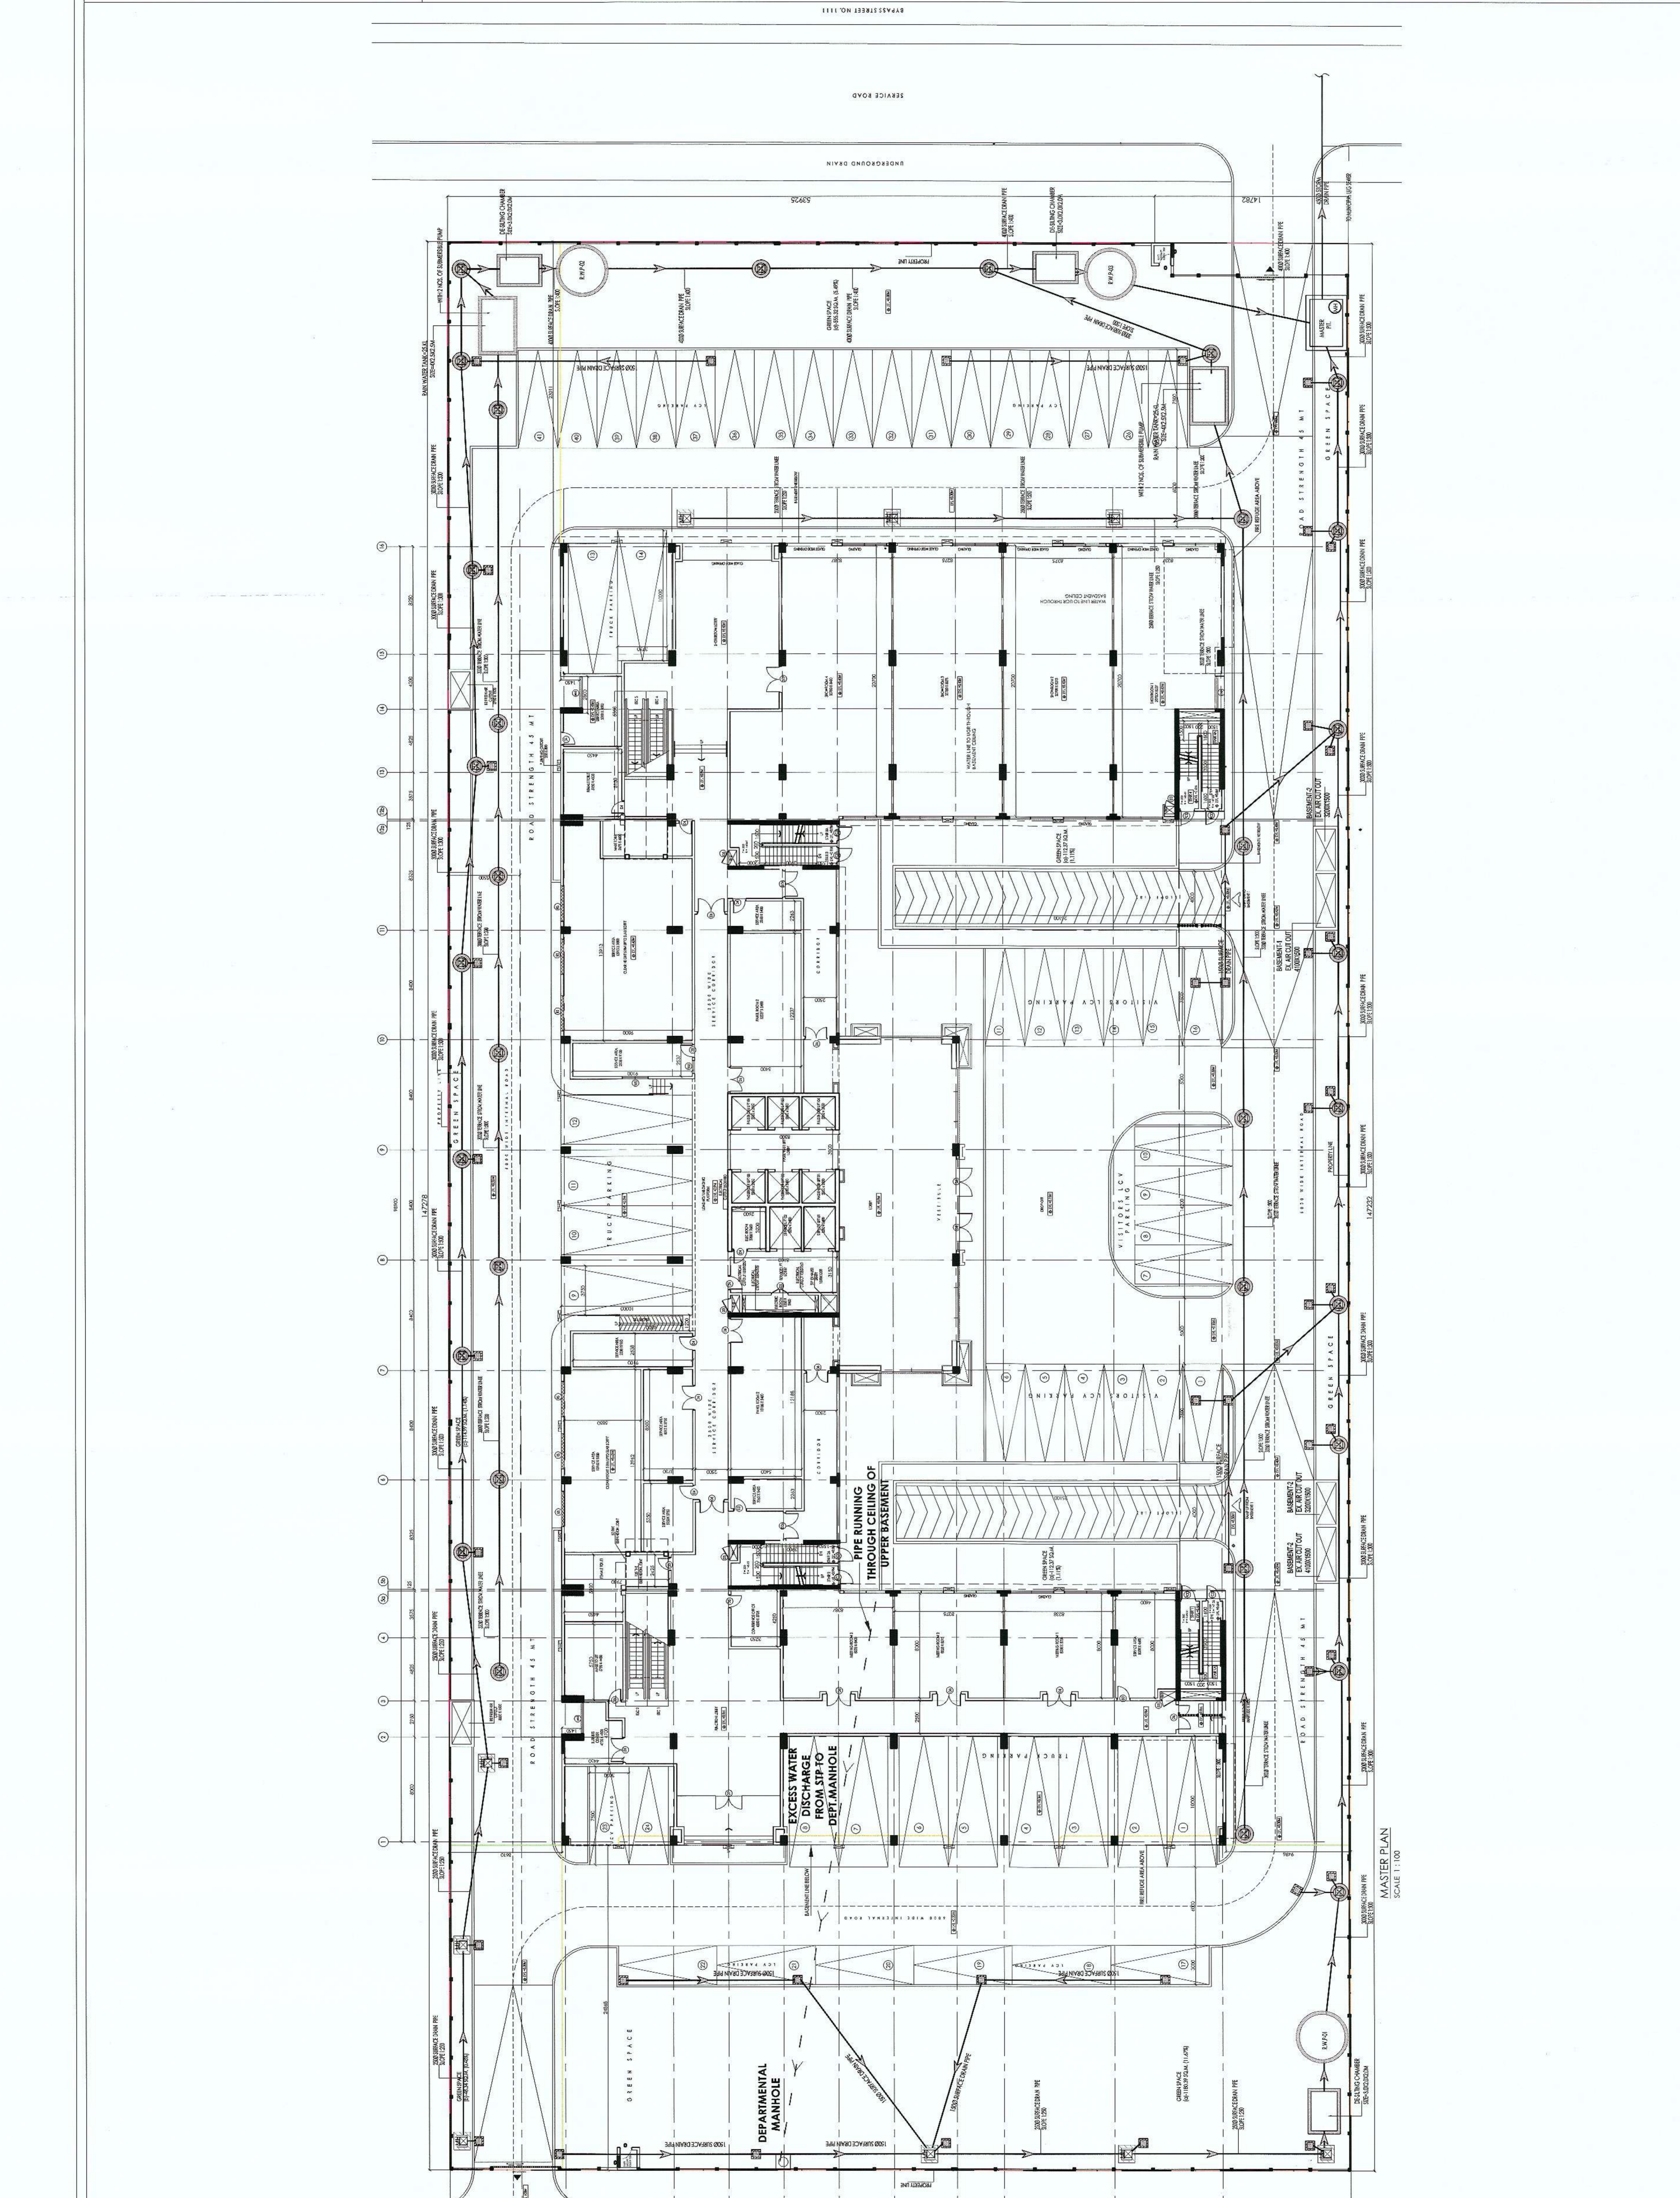

MASTER PLAN  
SCALE 1:100

PROPOSED 10-10B-G-VIII STORED OFFICE BUILDING  
AT PLOT NO. 11E/23 IN A-11 OF NEW TOWN, KOLKATA,  
UNDER NEW TOWN POLICE STATION

CONSULTANT :-  
M.N. CONSULTANTS ONE DESIGN SOLUTIONS  
15/6 RAJAGANGA MAIN ROAD,  
KOLKATA - 700107.

SCALE: 1:150  
DRAWN BY: BANGLATA  
CHECKED BY: PANRAJ  
APPROVED BY: ANIRBAN  
 Design Development  As Built Drawing  
 Contract Document  Consultation Day

DRAWING TITLE :-  
GROUND FLOOR PLAN SHOWING SEWERAGE &  
DRAINAGE LAYOUT

DWG NO. : MNV-AR-FR-111  
REV. NO. : 00



PLANTY'S COPY

- 1) Permitted to make Connection to the street bulk departmental permits provided for the plot
- 2) Proposed sewer level in the manhole.
- 3) Proposed spot elevation storm drain in the plot to street level in the drain.
- 4) Proposed spot elevation above the spot to be cleared from all the service lines by the plot holder.

NOTE  
 THIS SANCTION IS ONLY FOR THE PROPOSED/PROPOSED AND DRAINAGE LAYOUT PLAN

Plan: RIE 00222010306 DT: 21-Nov-2018

S. J. J. J.  
 Assistant Architect  
 New Town Urban Development Authority

S. J. J. J.  
 Chief Architect  
 New Town Urban Development Authority