



11TH FLOOR PLAN

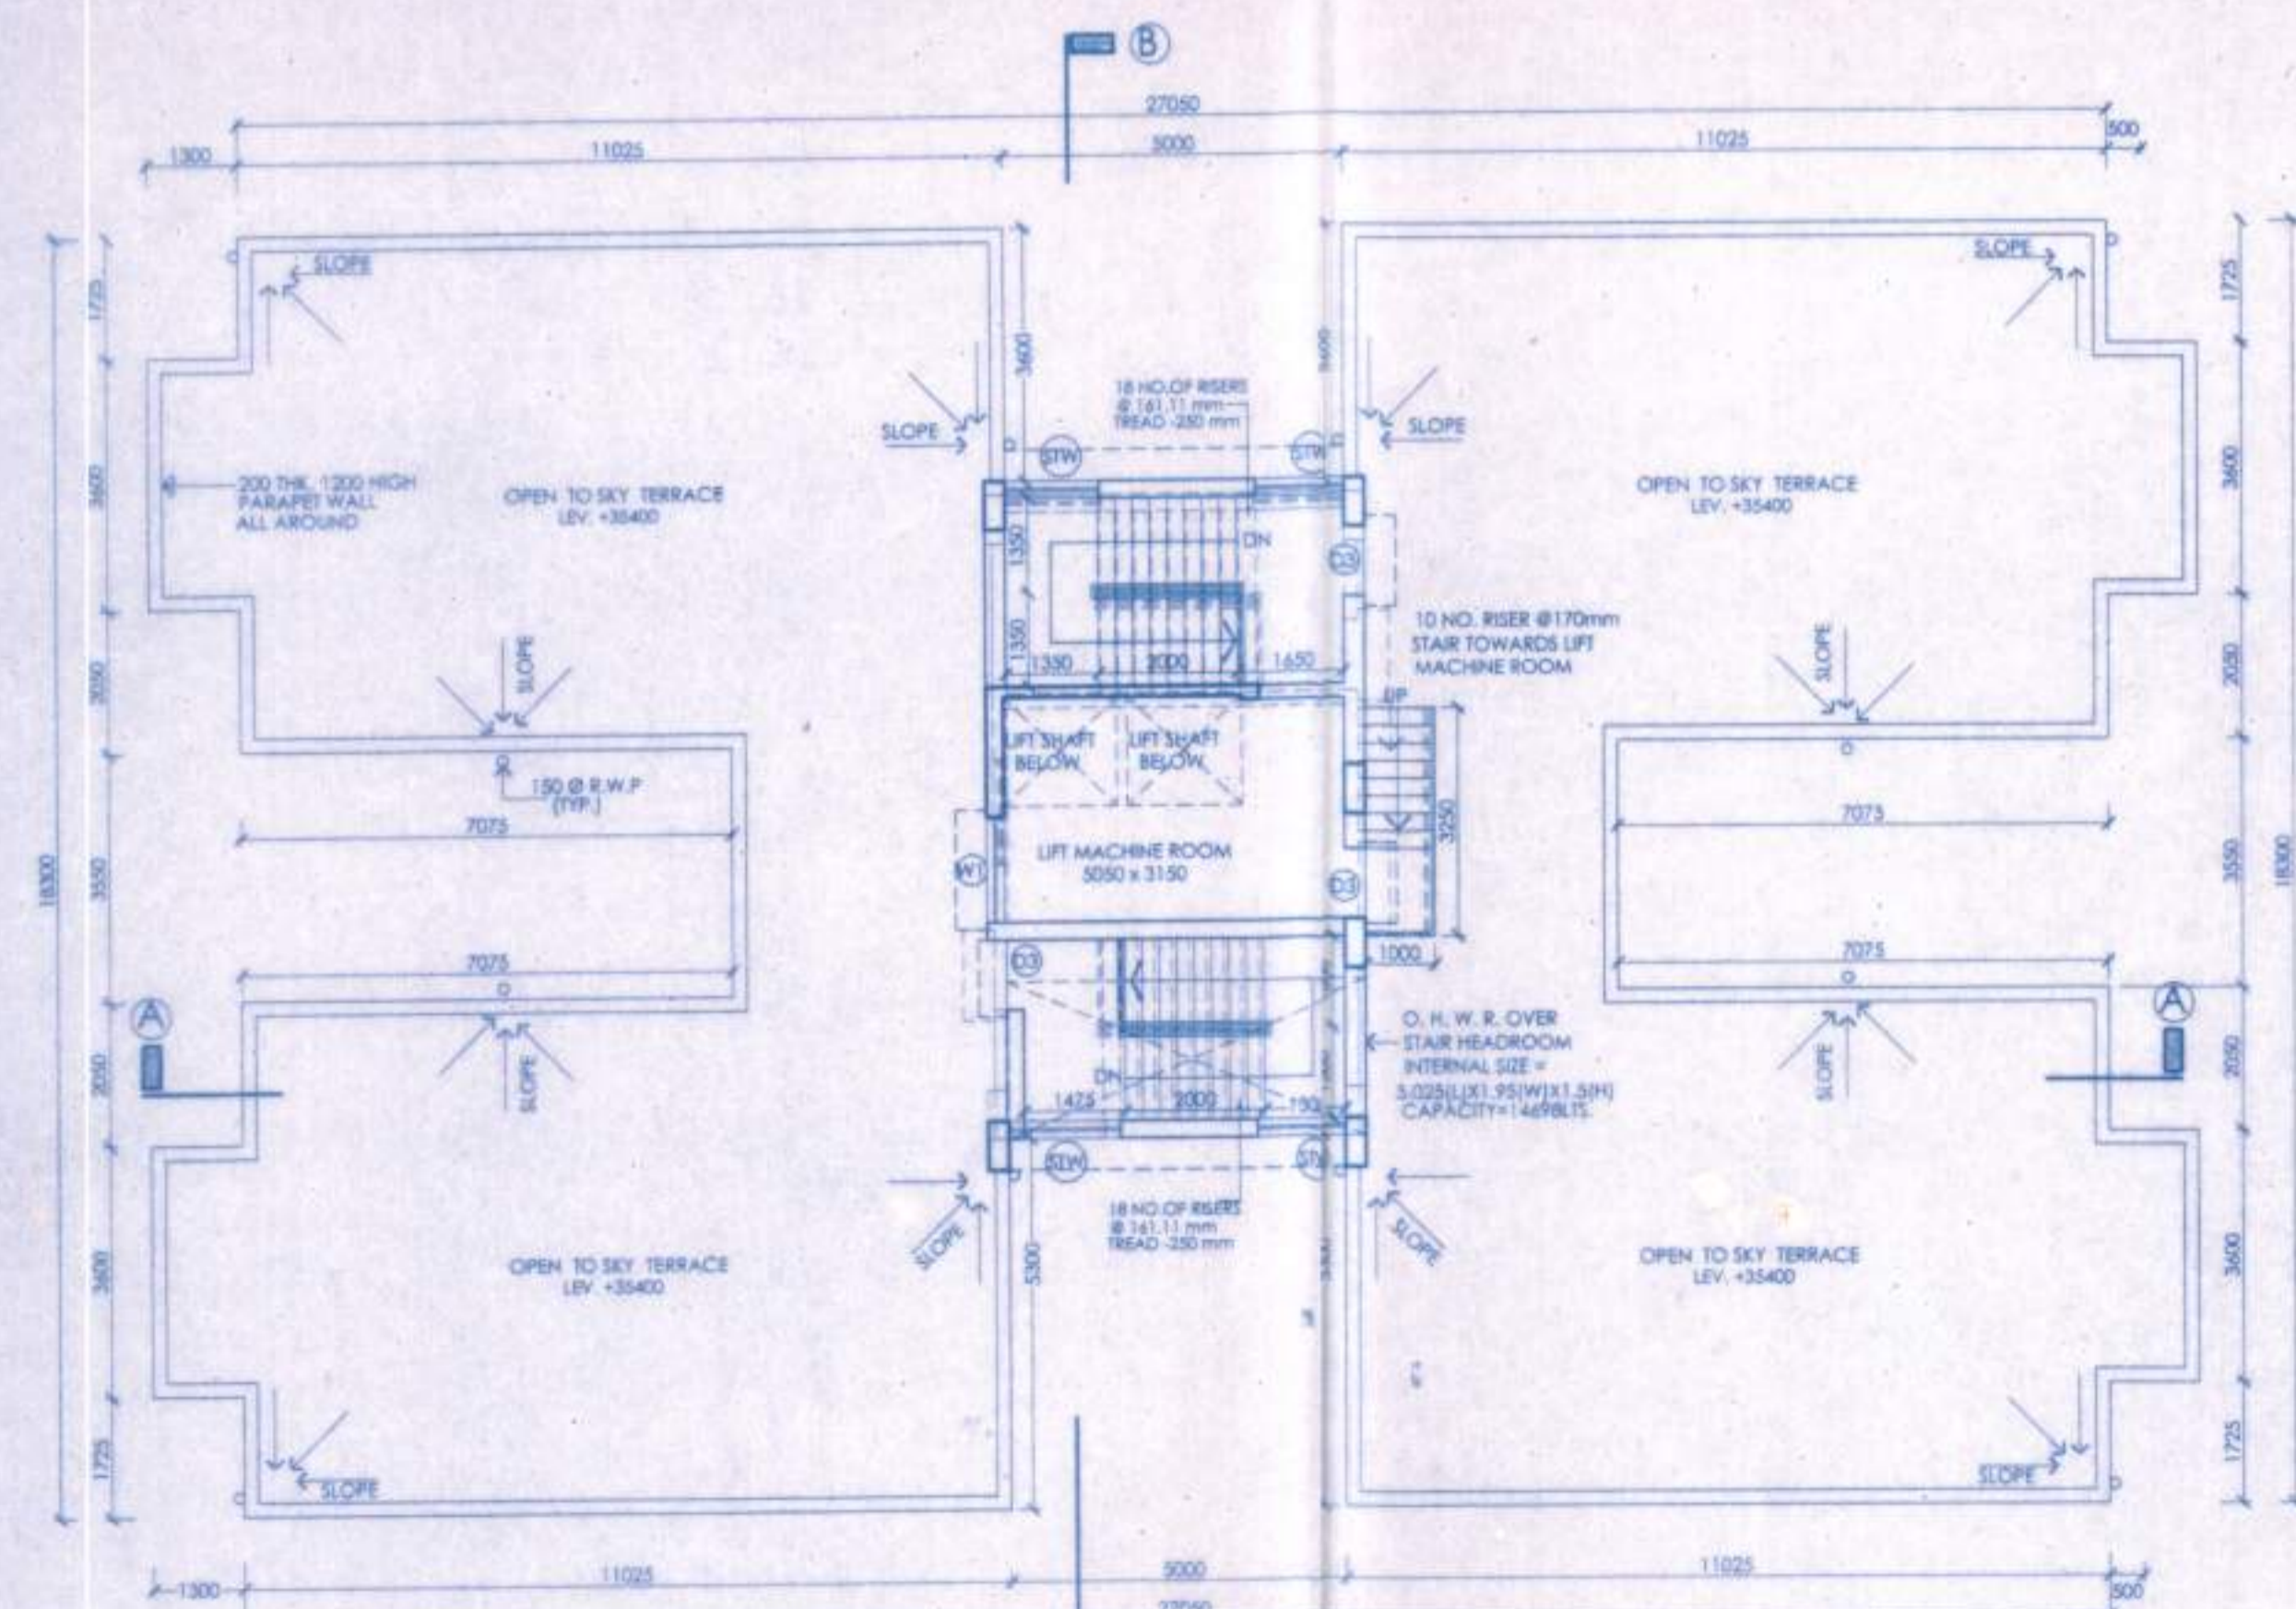

ROOF PLAN

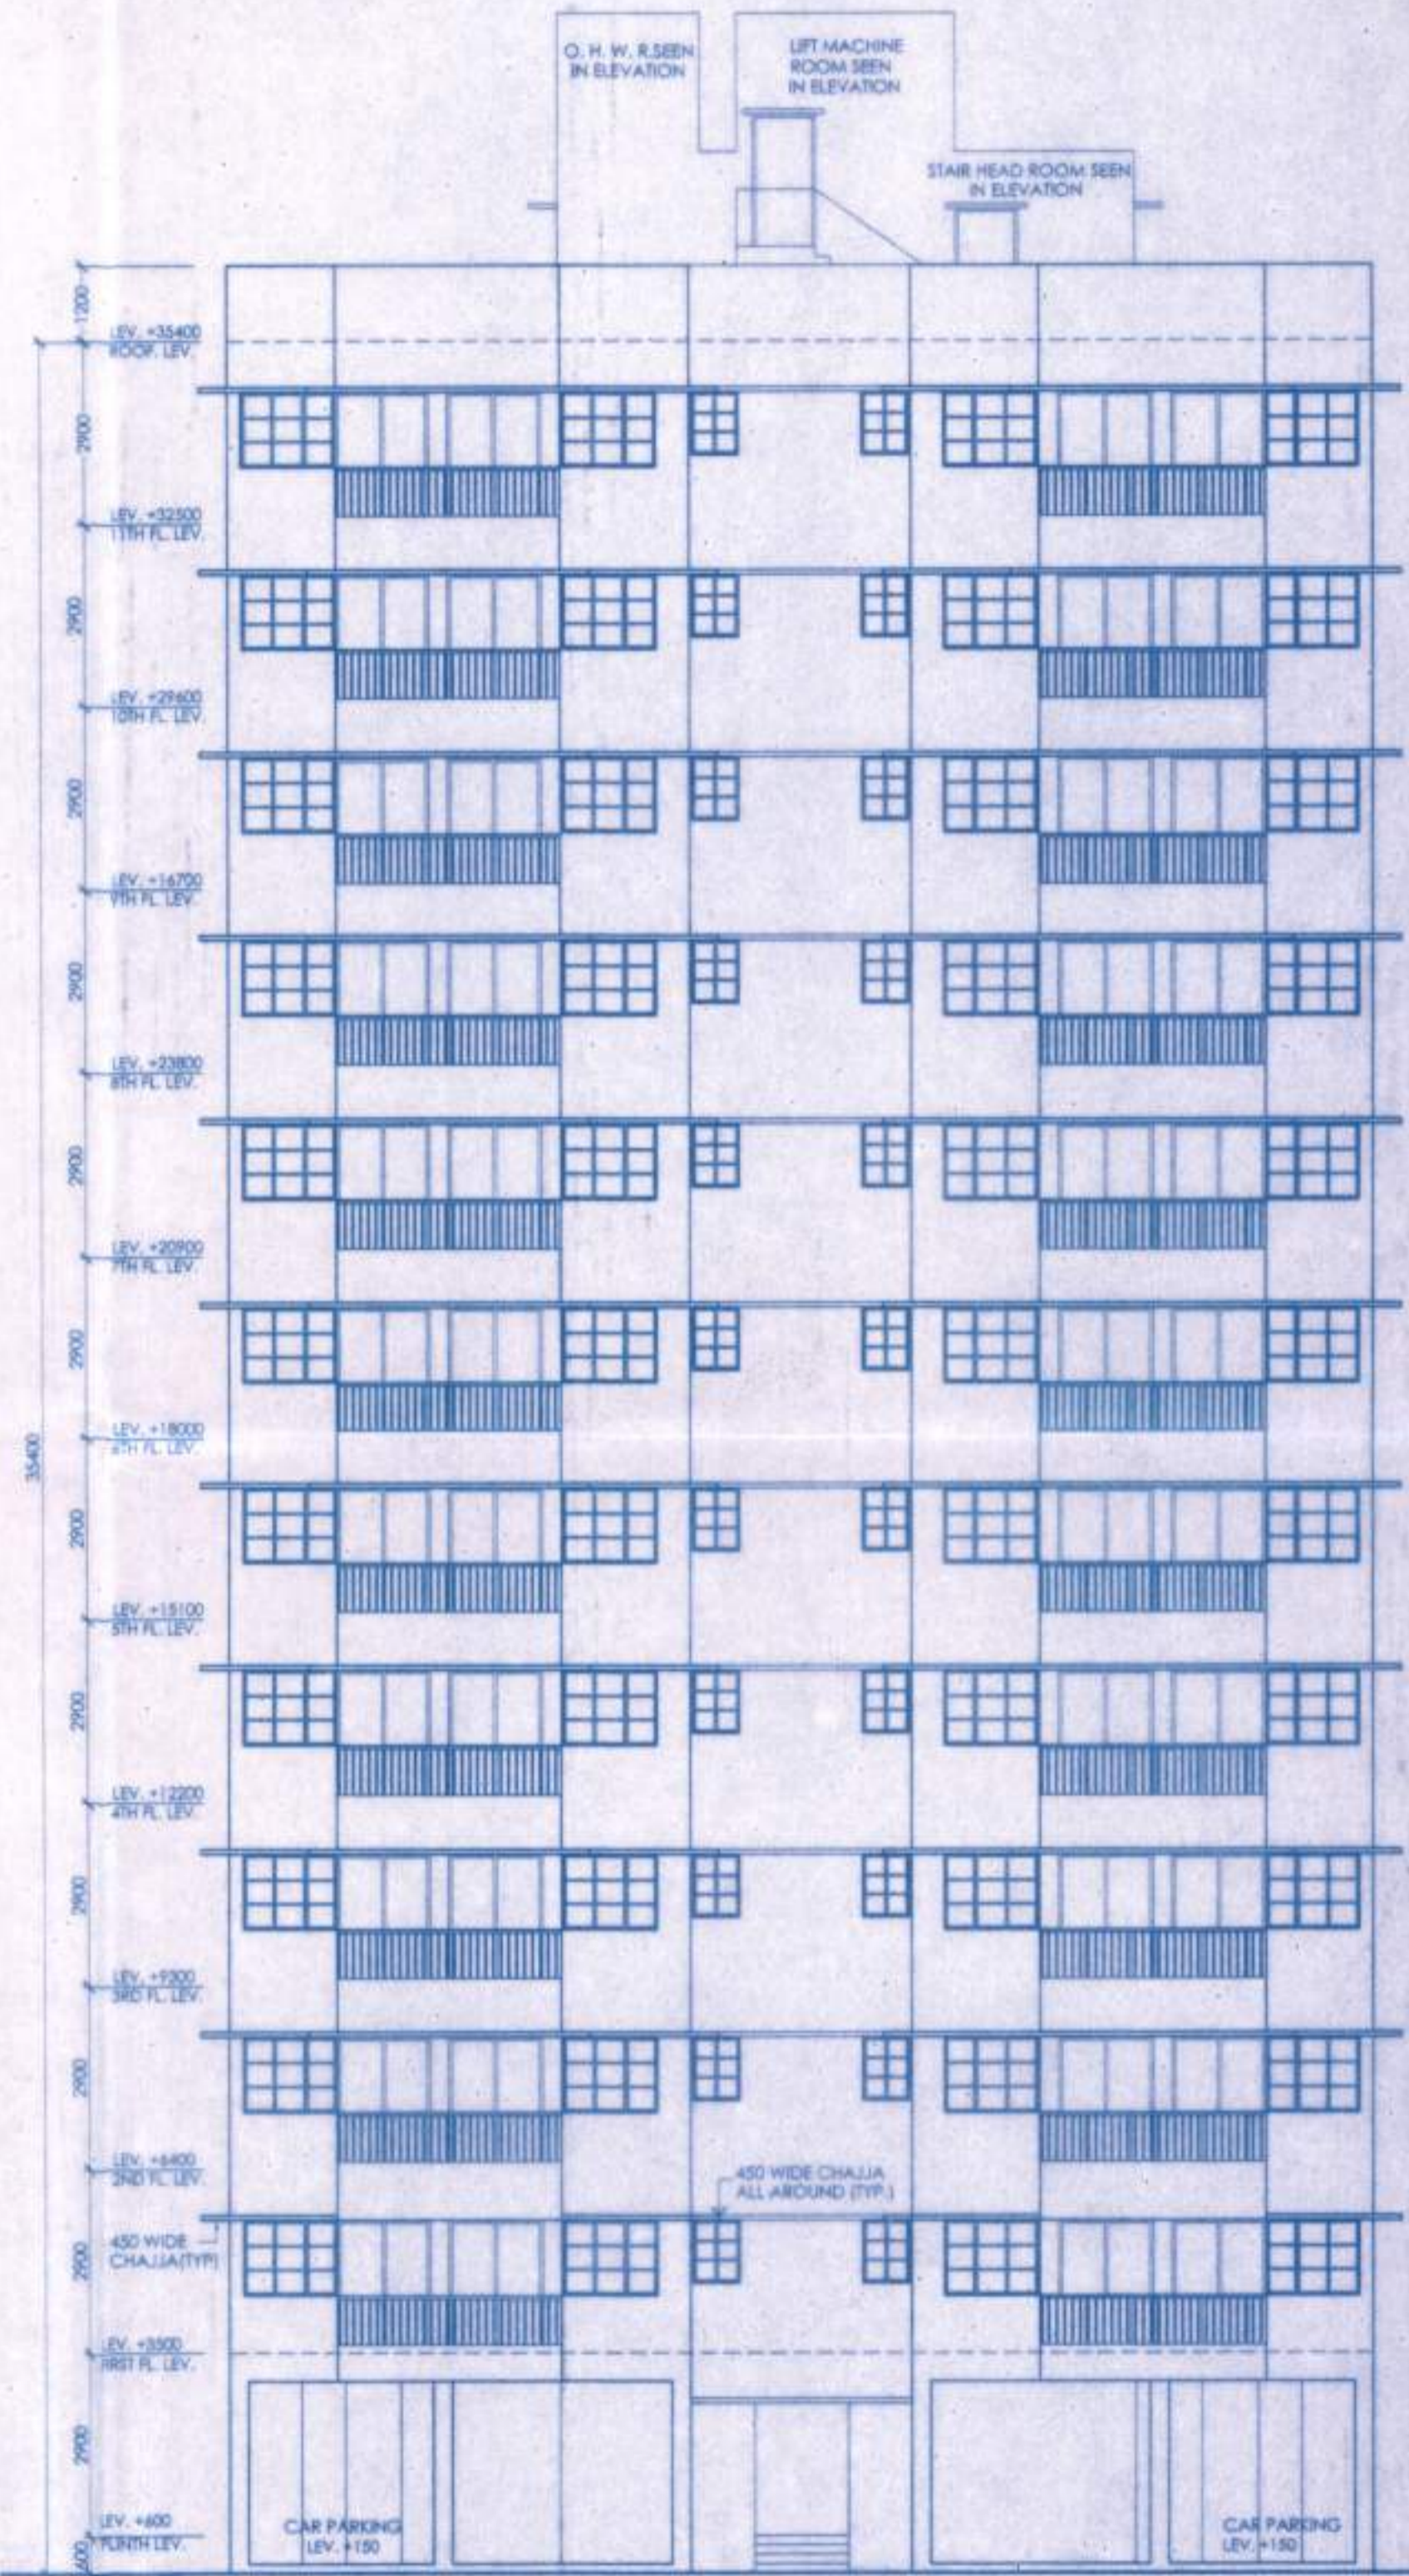

FRONT ELEVATION ( NORTH-WEST)

**NOTES:**  
 STRUCTURE SHOWN IN YELLOW FIRM LINE ARE SANCTIONED & SHALL BE CONSTRUCTED.  
 STRUCTURE SHOWN IN YELLOW DOTTED LINE ARE SANCTIONED BUT SHALL NOT BE CONSTRUCTED.  
 STRUCTURE SHOWN IN RED HATCH ARE NOT SANCTIONED BUT PROPOSED FOR CONSTRUCTION.

THE DRAWING IS A PRIVATE AND CONFIDENTIAL COMMUNICATION AND THE PROPERTY OF MANIRAMKA AND ASSOCIATES AND MUST NOT BE COPIED OR LENT WITHOUT THE CONSENT OF MANIRAMKA AND ASSOCIATES.  
**NOTES:**  
 FOR DOOR AND WINDOW SCHEDULE REFER DRG. NO. - FORTUNE HEIGHTS/SD/BLK-G/3/F

**CERTIFICATE OF ARCHITECT**  
 I DO HEREBY CONFIRM AND CERTIFY WITH FULL RESPONSIBILITY THAT THE BUILDING PLAN HAS BEEN PREPARED BY ME KEEPING THE PROVISION OF N.B.C. OF INDIA AND CERTIFY THAT IT IS SAFE AND STABLE IN ALL RESPECT

*Sunil Maniramka*  
 SUNIL MANIRAMKA (B. Arch)  
 Consulting Architect  
 Council of Architecture (Reg. No. CA/93/16630)

SUNIL MANIRAMKA  
 74B, A.J.C. BOSE ROAD  
 KOLKATA-16

SIG. OF ARCHITECT

**CERTIFICATE OF ENGINEER**  
 THE STRUCTURAL DESIGN AND DRAWINGS OF BOTH FOUNDATION AND SUPER STRUCTURE OF THE BUILDING HAS BEEN MADE BY ME CONSIDERING THE SOIL TEST REPORT SUBMITTED BY GEOCON, 35, BADAN ROY LANE, BELAGHATA, KOLKATA - 700010, AND ALSO CONSIDERING ALL POSSIBLE LOADS, SEISMIC LOAD AND THE MOMENTS GENERATED BY THE PROPOSED STRUCTURE AS PER BIS & THE NATIONAL BUILDING CODE OF INDIA & CERTIFIED THAT IT IS SAFE & STABLE IN ALL RESPECT & THESE PROVISIONS SHALL BE ADHERED TO DURING THE CONSTRUCTION.

*C.P. Khanra*  
 CHANDI PRASAD KHANRA  
 BR (CIVIL), ME (STRUCT.), MIE (INDIA)  
 ESE - 1/2

CHANDI PRASAD KHANRA  
 53/22, BRIDABAN MULLICK LANE  
 HOWRAH - 711101

SIG. OF STR. ENGINEER

**CERTIFICATE OF GEO-TECHNICAL ENGINEER**  
 THIS IS TO CERTIFY THAT THE SOIL TEST HAS BEEN PERFORMED BY ME FOR THIS PROJECT

*Prasanta Kumar Ghosh*  
 Prasanta Kumar Ghosh  
 Geotechnical Engineer  
 B.E., M.Tech., M.I.G.S., (M-358)

PRASANTA GHOSH  
 GEOCON-35, BADAN ROY LANE  
 BELAGHATA  
 KOLKATA-10

SIG. OF GEO-TECHNICAL ENGINEER

**CERTIFICATE OF OWNER**  
 THIS IS TO CERTIFY THAT I SHALL NOT ON A LATER DATE MAKE ANY ADDITION OR ALTERATION TO THIS PLAN. IT IS CERTIFIED THAT I HAVE GONE THROUGH THE N.B.C. OF INDIA AND ALSO ABIDE BY THOSE RULES DURING AND AFTER CONSTRUCTION OF BUILDING

*Ravi Shankar Bhattacharya*  
 Ravi Shankar Bhattacharya  
 Director

SIG. OF OWNER

**PROJECT**  
 REVISED PLAN OF G+11 (35.4 M. HT.) STORIED BUILDING NOS. (A,B,C,I,J,K,L,M,N,D,H,F,G & CLUB) AND G+7 (23.8 M. HT.) STORIED BUILDING NO. E, AT 168 KRISHNANAGAR ROAD (NH -34); R.S./L.R. DAG/NO 1576, 1577, 1578, 1579, 1581, 1589, 1590, 1591, 1592, 1593, 1594, 1599, 1600, 1600/1754, 1600/1755, 1578/1752, 1578/1753, 1579/1752 AND 1599/1756 UNDER L.R.KHATIAN NO.1772 UNDER MOUZA: MOYNAGADI, J.L.NO. 06 IN SANSAD NO.-VII UNDER P.O.- NOAPARA, P.S -BARASAT, NORTH 24 PARGANAS UNDER PASCHIM KHILKAPUR GRAM PANCHAYAT, WEST BENGAL. PREVIOUS SANCTIONED S.L. NO.- 64, DATED ON- 27.02.2014

**SANCTION DRAWING**  
 BLOCK-G

11TH FLOOR PLAN, ROOF PLAN, ELEVATION

STRUCTURAL CONSULTANTS: Mr. Chandi Prasad Khanra  
 BE (CIVIL), ME (STRUCT.), MIE (INDIA)

DATE: 30.08.16 SCALE: 1:100 DEPT: RUCHRA DRG. NO.- FORTUNE HEIGHTS/SD/BLK-D/3/F

ARCHITECTS:  
 MANIRAMKA AND ASSOCIATES  
 74B, A. J. C. BOSE ROAD, KOLKATA-700 016  
 PHONE: (033) 2217 8329  
 E mail: manirankg@vsnl.net

NORTH AS/SITE  
 RD

PLAN PERMITTED  
 16-8-16



SL No-53  
 dt-16/8/16