

CERTIFICATE OF OWNER

CERTIFIED THAT I HAVE GONE THROUGH THE BUILDING RULES FOR BIDHAN NAGAR & ALSO UNDERTAKE TO ABIDE BY THOSE RULES DURING & AFTER THE CONSTRUCTION OF THE BUILDING.

CERTIFIED THAT I SHALL NOT ON LATER DATE MAKE ANY ADDITION OR ALTERATION TO THIS PLAN SO AS TO CONVERT IT FOR MY USE OR ALLOW IT TO BE USED FOR TWO SEPERATE FLATS PER FLOOR / PER STOREY.

For, TECHNICS
SHANKAR LAL SAHA
Proprietor

Rabindra Nath Sankar

Constituted Attorney

SIGNATURE OF OWNER

CERTIFICATE OF ARCHITECT

CERTIFIED THAT THE PLAN ELEVATION AND SECTIONS AND OTHER STRUCTURAL DETAILS OF THE PROPOSED BUILDING ON PLOT NO -11 , BLOCK - DN, UNDER THE JURISDICTION OF NDITA HAS BEEN DESIGNED AND DRAWN UP STRICTLY ACCORDING TO THE PROVISIONS OF THE WEST BENGAL MUNICIPAL (BUILDING) RULES 2007. THIS ALSO TO CERTIFY THAT ALL RELEVANT NO OBJECTION CERTIFICATES FROM THE RESPECTIVE AUTHORITIES AS APPLICABLE IN THIS REGARD.

B. B. Choudhury
B. B. CHOUDHURY
Registered Architect
CA/89/12330

SIGNATURE OF L.B.A
NAME-
EMPANELMENT NO.-

CERTIFICATE OF ENGINEER

CERTIFIED THAT THE FOUNDATION AND SUPERSTRUCTURE OF THE THE BUILDING PROPOSED FOR CONSTRUCTION ON PLOT NO -11 , BLOCK - DN UNDER THE JURISDICTION OF NDITA HAS BEEN PERSONALLY INSPECTED AND SO DESIGNED BY ME WILL MAKE SUCH FOUNDATION AND SUPER STRUCTURE SAFE IN ALL RESPECT INCLUDING THE CONSIDERATION OF BEARING CAPACITY AND SETTLEMENT OF SOIL AND OTHE CONDITIONS, IF ANY, CONFORMING TO ALL STIPULATIONS OF ALL RELEVENT IS CODES OF PRACTICE AND NATIONAL BUILDING CODE.

Umesh Mishra
UMESH MISHRA
BE.(CIVIL), ME.(STR), MBA.(SYT)
CHARTERED ENGINEER
KMC-LBS 1/1176, ESE 1/182

SIGNATURE OF ENGINEER
NAME-
EMPANELMENT NO.-

SIGNATURE OF GEO-TECHNICAL ENGINEER
NAME-
EMPANELMENT NO.-

CERTIFICATE OF REVIEWER:

CERTIFIED THAT THE BUILDING SITE PROPOSED FOR CONSTRUCTION AT PLOT NO-11, BLOCK - DN UNDER THE JURISDICTION OF NDITA HAS BEEN VISITED BY ME AND ALL THE DESIGN, DRAWNGS SOIL TEST AND LOAD TEST RESULTS FOR FOUNDATION AND SUPERSTRUCTURE HAVE BEEN DULY REVIEWED CONFORMING TO STIPULATIONS OF ALL LATEST RELEVENT IS CODE OF PRACTICE AND NATIONAL BUILDING CODE AND IT IS FOUND THAT EVERYTHING IS COMPLETELY IN ORDER AND THE PROPOSED FOUNDATION AND SUPERSTRUCTURE ARE SAFE IN ALL RESPECT.

Nirmalya Chatterjee
NIRMALYA CHATTERJEE
B.E.(Civil), ME.(Struct), AMIE
Empanelled Structural Engineer K.M.C.
Licenses No.- E.S.E./1/181

AREA STATEMENT

AREA OF LAND : 677.1712 SQM

CAR PARKING REQUIRED : 580.50 SQM

CAR PARKING PROVIDED: 595.45 SQM

BUILT UP AREA
EXCLUDING
CARPARKING

BASEMENT FLOOR : 20.0112 SQM

GROUND FLOOR = 326.4912 SQM

FIRST FLOOR = 349.7212 SQM

2ND. FLOOR TO 8TH. FL.:- 2571.9204 SQM

ABOVE ROOF: 49.0 SQM

TOTAL : 3317.144 SQM

TOTAL BUILDUP AREA: (326.4912X3)+

(377.367X9)+49.0 = 4047.38 SQM

SCHEDULE OF DOOR & WINDOWS

No.	Mkd.	Size		Description
		Width	Height	
1.	W1	2400	1500	
2.	W2	750	750	
3.	W3	1200	1200	
4.	D1	2000	2100	
5.	D2	1500	2100	
6.	D3	750	2100	
7.	D4	900	2100	
8.	D5	1200	2100	
9.	D6	1000	2100	
10.	FCD	1500	2100	
11.	FCD1	1200	2100	

PROJECT

**AS BUILT PLAN OF BASEMENT+G+9 STORIED
BUILDING IN BLOCK- DN, PLOT-11, SECTOR - V,
SALT LAKE CITY.**

NAME OF CLIENT : M/S. TECHNICS.

PROP. : SRI SANKAR LAL SAHA.

SCALE
1:100, 1:25, 1:500

DATE
04.12.17

DRG. NO.

2

DRAWN BY-

CHECKED BY _____

NOTE -

(1) ALL EXTERNAL WALLS ARE 250 THK. AND ALL
INTERNAL WALLS ARE 125 THK.

(2) ALL R.C.C CHAJJA ARE 450 PROJECTED

DESIGNED BY:-

M M C S (P) LTD.



FD - 396 , SECTOR - III.

SALT LAKE CITY.

KOLKATA - 700 106.

PH:- 4004 5307 .

email:- umes_mmcs_2006@yahoo.co.in

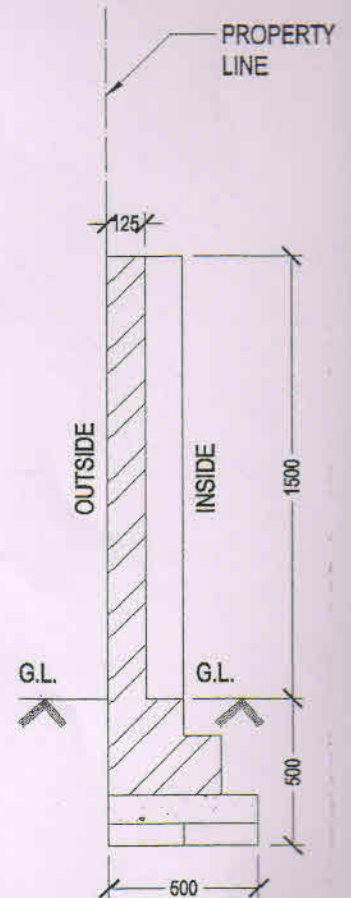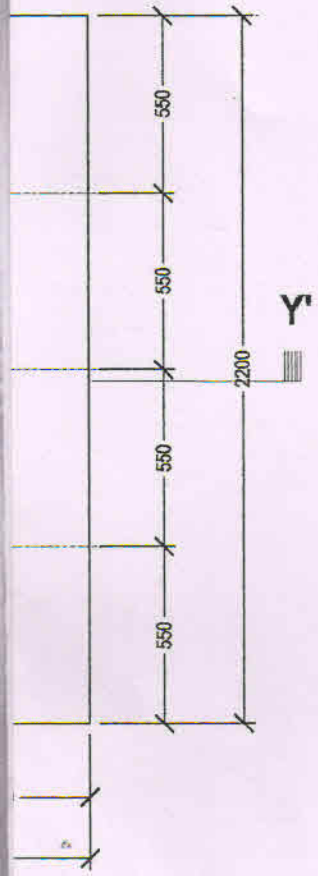

DETAIL OF BOUNDARY WALL

(Scale :- 1 : 25)


100TH. LIME TERRACING OVER
100TH. RCC SLAB


STAIR ROOF LEV

ROOF LEV.


9TH FL. LEV.

100TH. LIME TERRACING
100TH. RCC SLAB

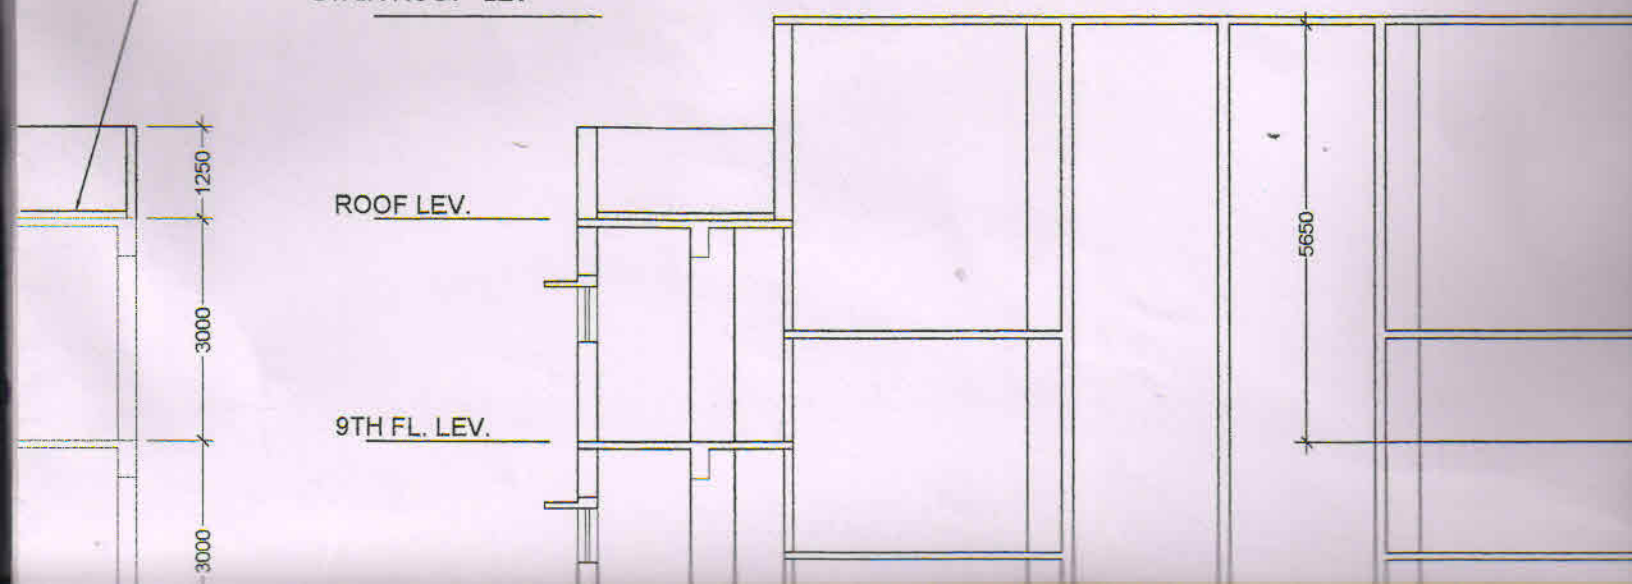

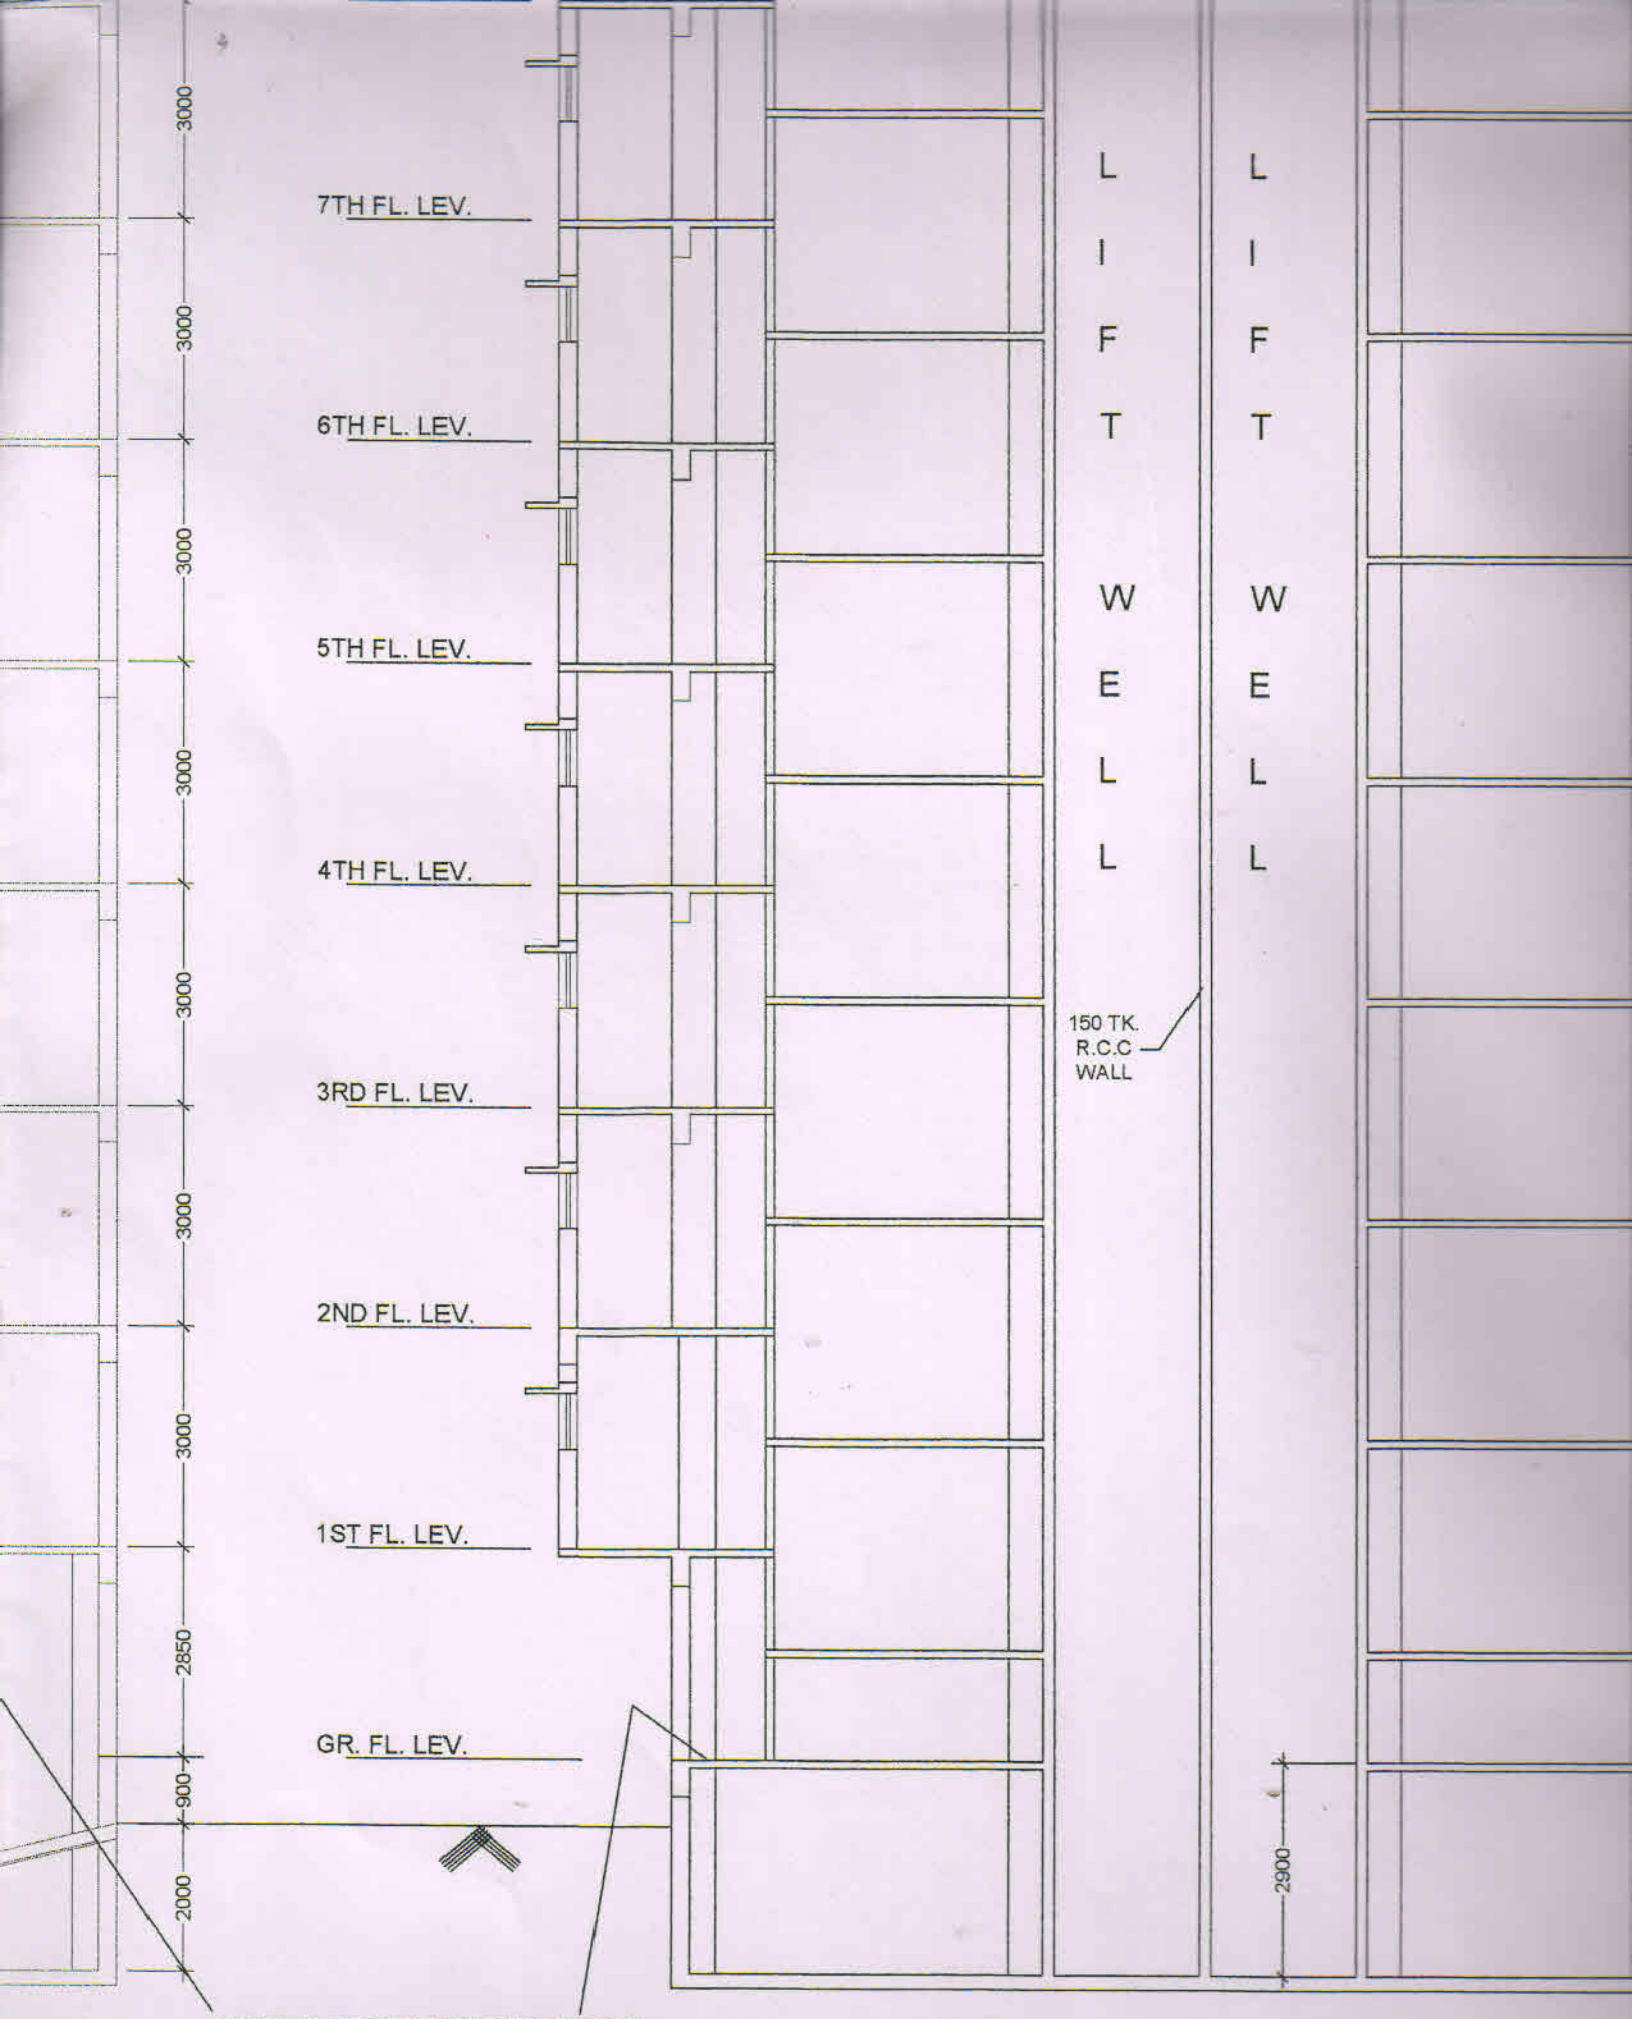


SECTION AT B- B

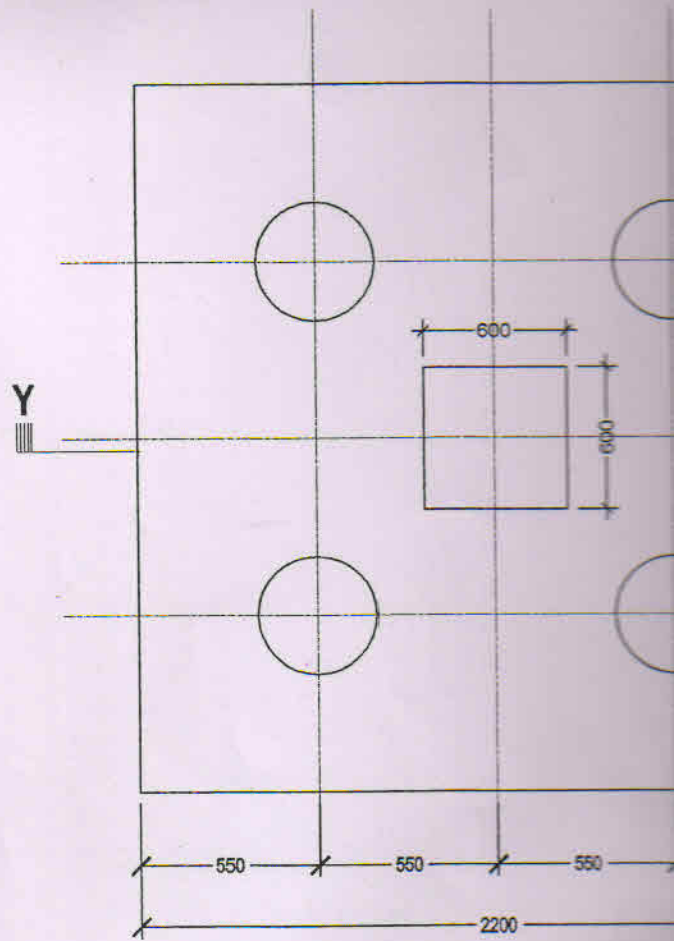

PLAN
DETAIL OF PILE FOUNDATION
 (SCALE :- 1 : 25)

SECTION LINE CHANGE

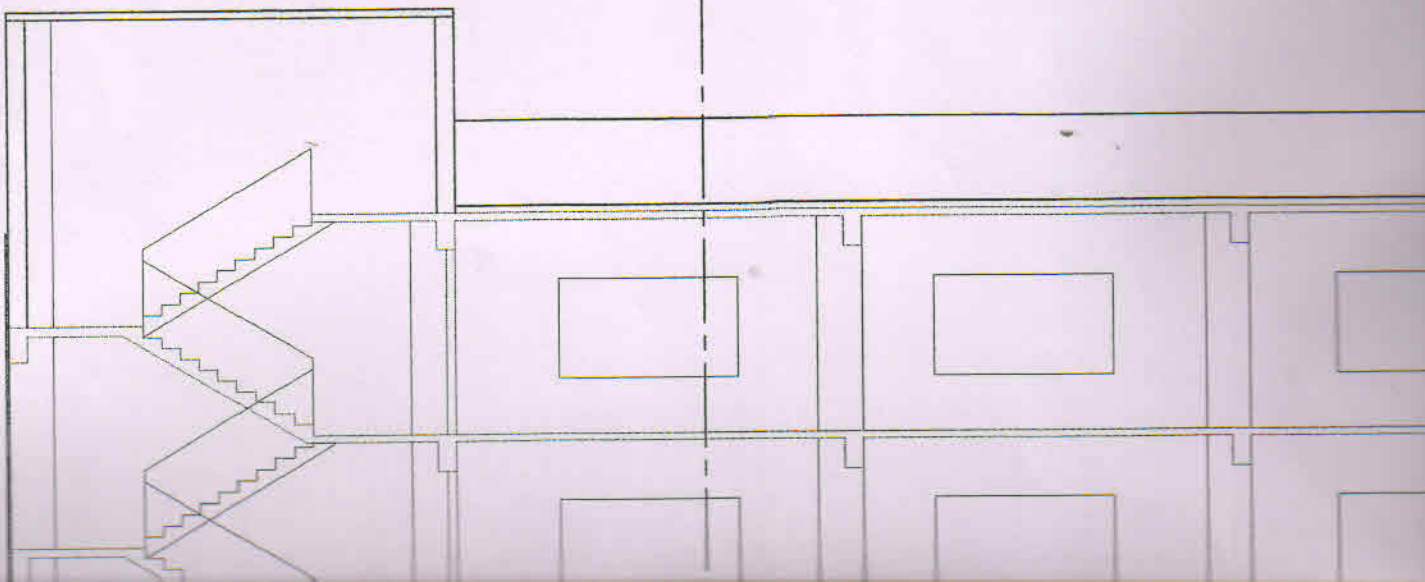



REFUGEE AREA 15 Sq.M.

GR. FL. LEV.
-900
1500

SECTION AT A-A

2000

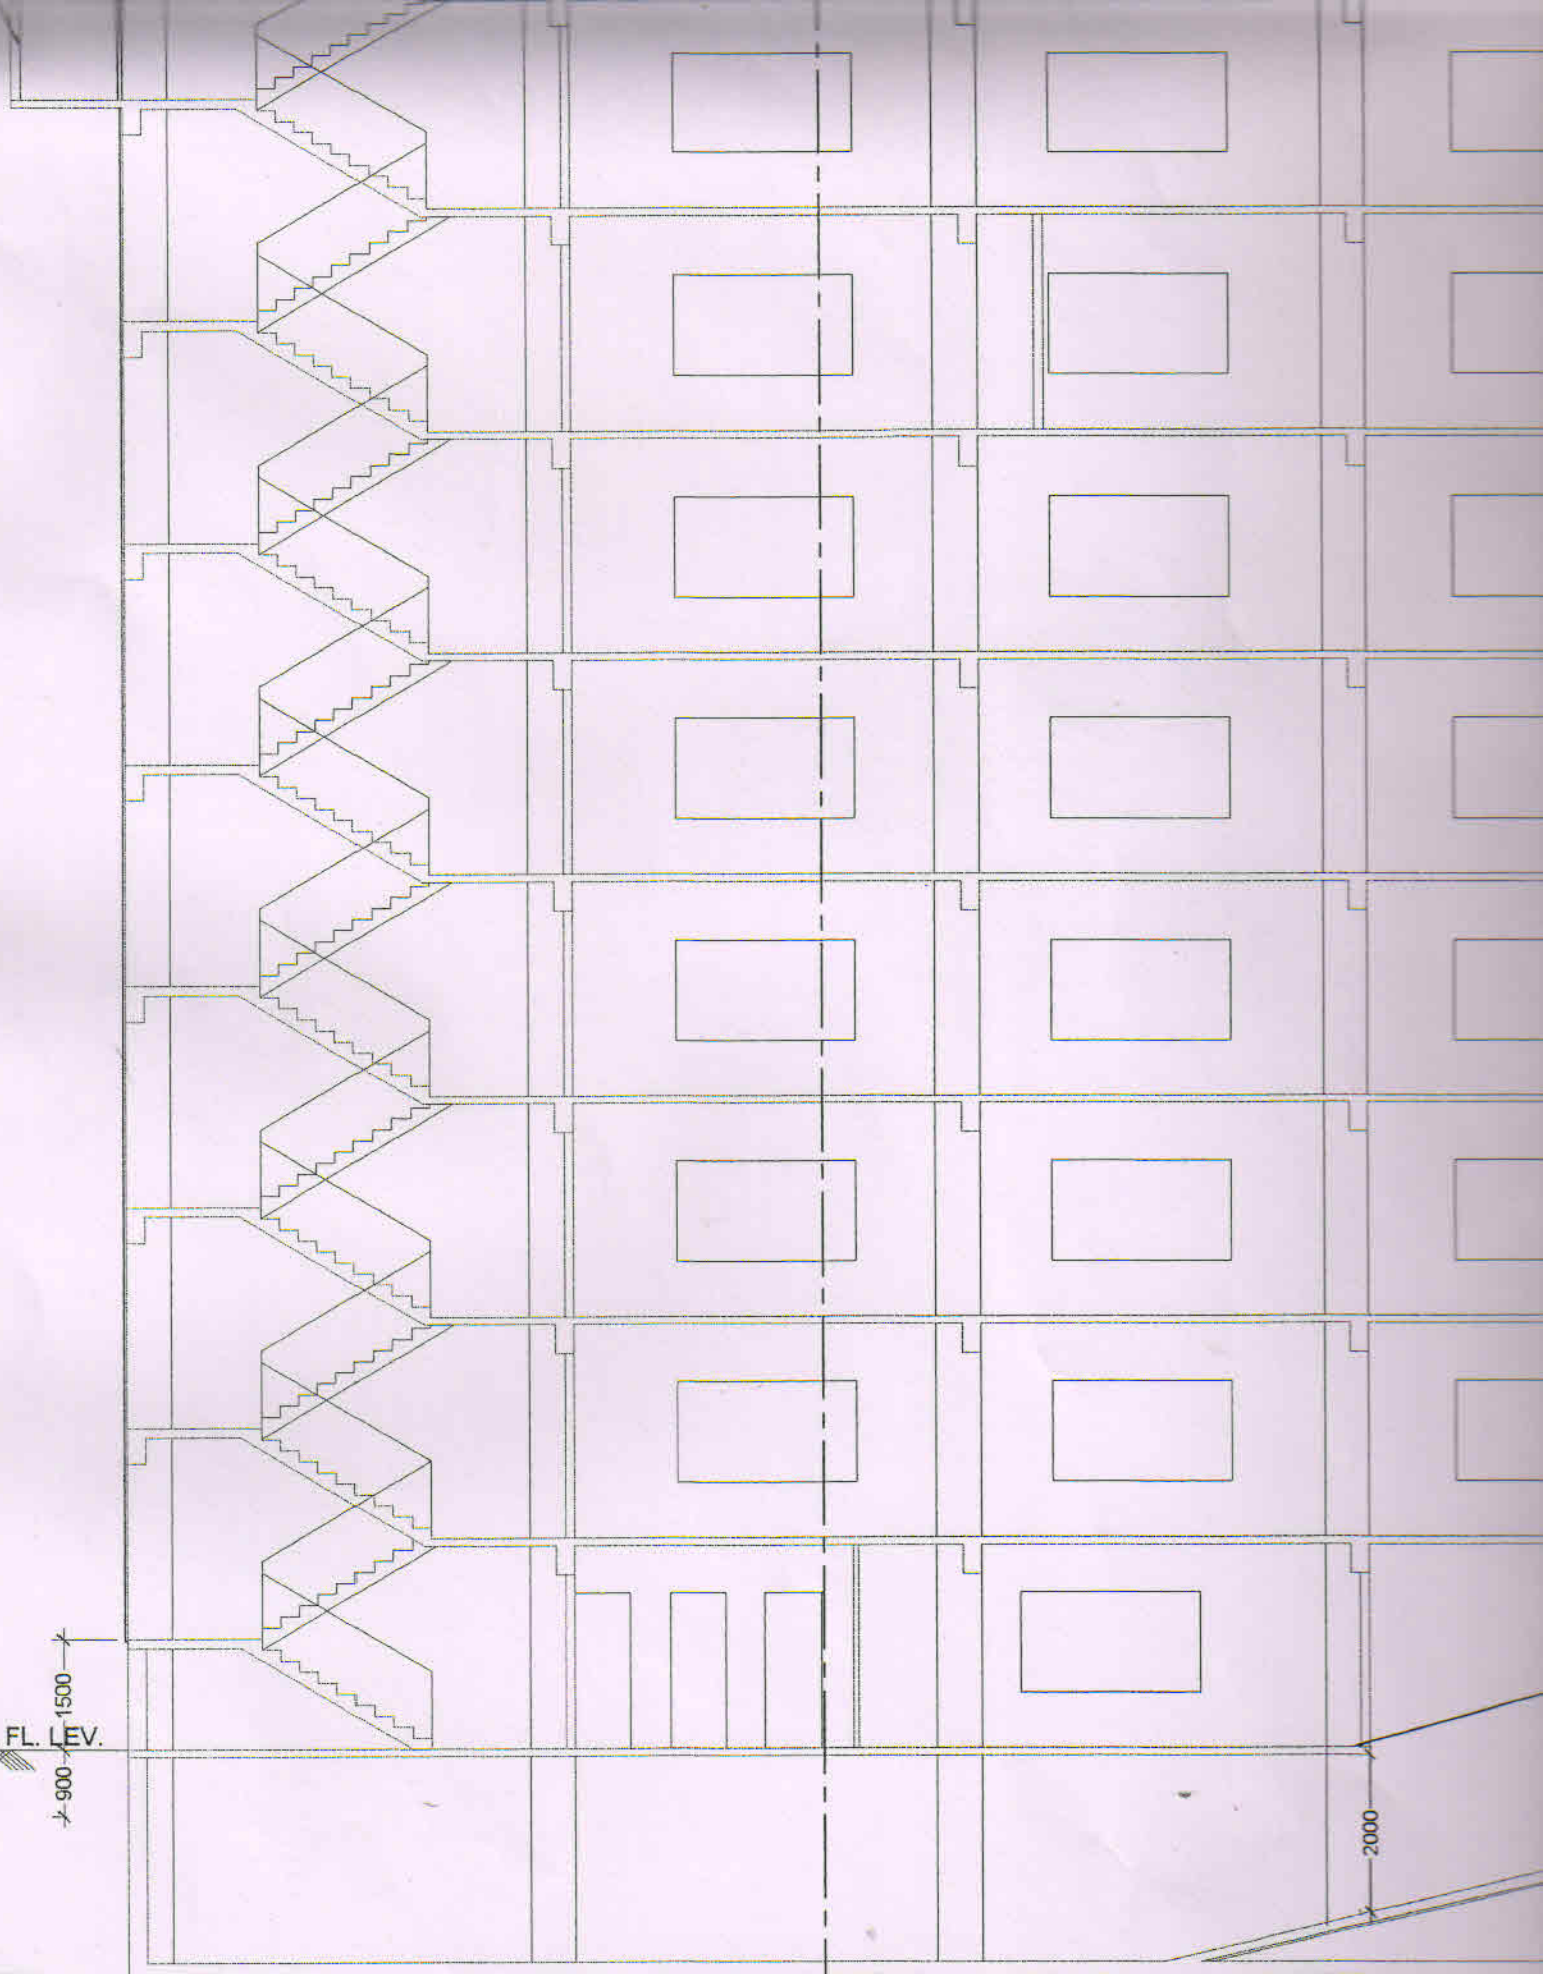

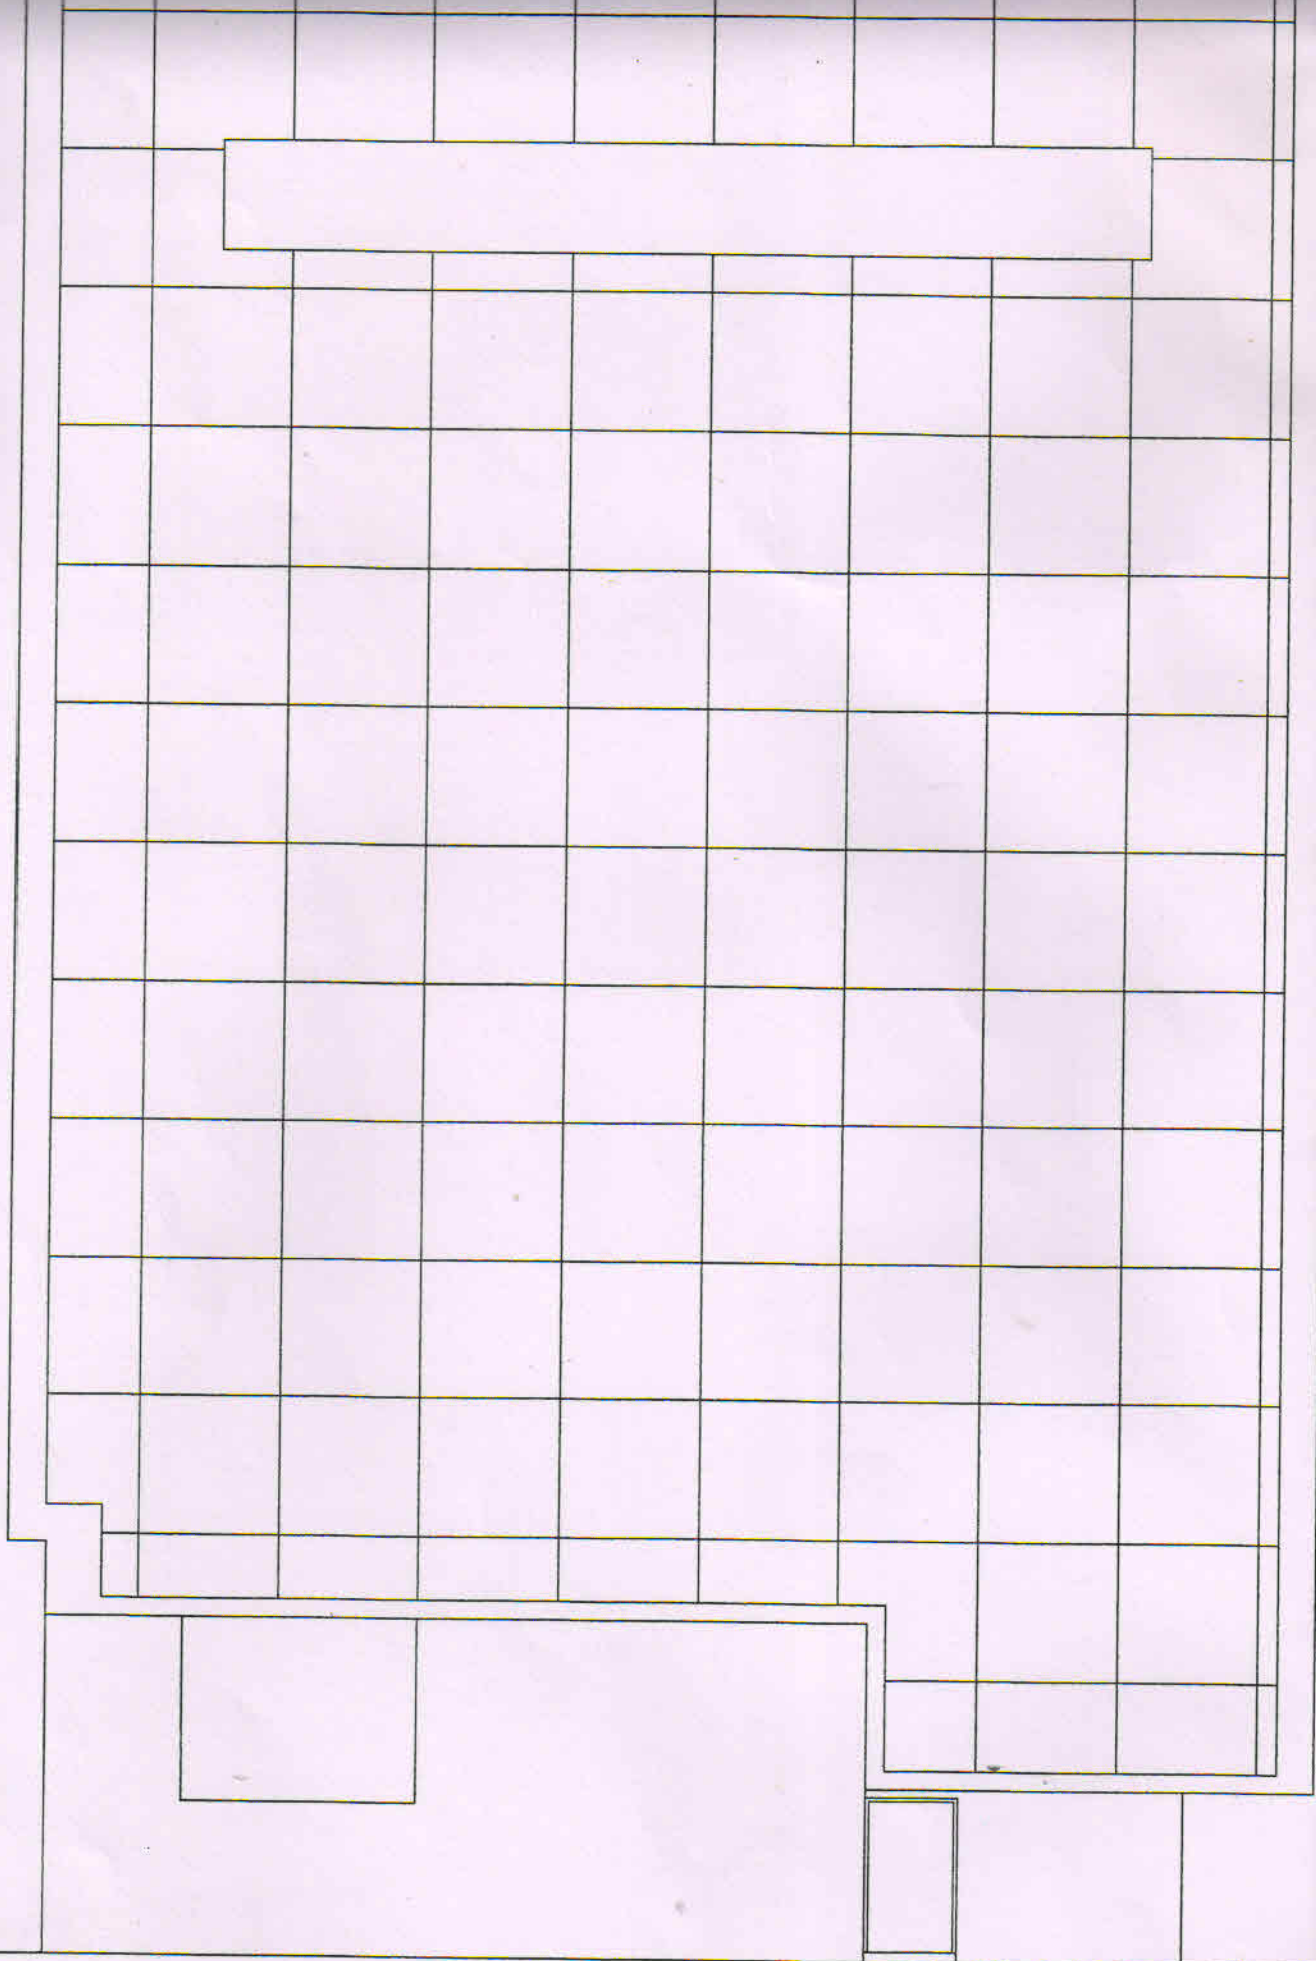

FRONT ELEVATION