THE DRAWINGS IS THE PROPERTY OF M/S. CONSULTANT ONE DESIGN SOLUTIONS AND IS SUPPLY / LENT FOR LIMITED USE SUBJECT TO THE CONDITION THAT IT SHALL NOT BE REPRODUCED LENT OR USED IN ANY WAY DETRIMENTAL TO OUR INTEREST

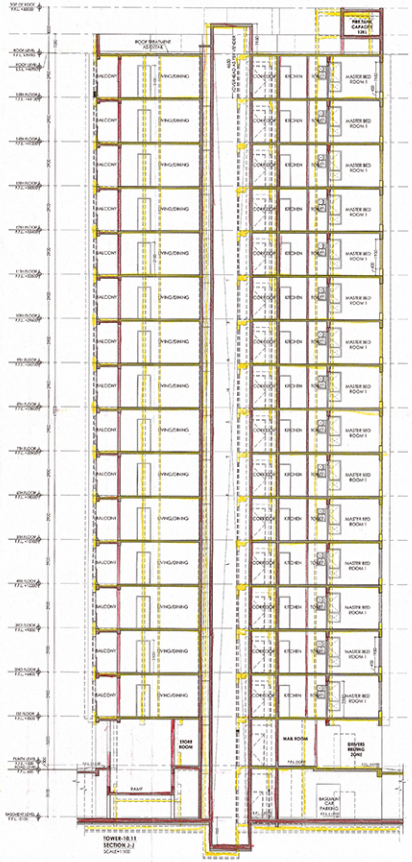

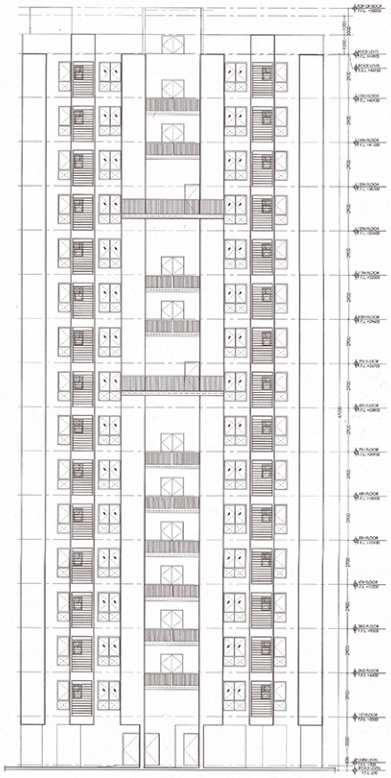

NAME OF OWNERS :

PS VINAYAK COMPLEX LLP
PARTNER
AS CONSTITUTED ATTORNEYS OF

1. BRATATI MUKHOPADHYAY
2. SIDDHARTHA MUKHERJEE
3. PHOBOS TOURS & TRAVEL PVT. LTD.
4. THYONE RETAIL PVT. LTD.
5. GALTONIA BUILDERS PVT. LTD.
6. THYONE HERBAL PRODUCTS PVT. LTD.
7. CISSONIA HEIGHTS PVT. LTD.
8. SYDDOS AGRO MARKETING PVT. LTD.
9. PHLOMIS DEVELOPERS PVT. LTD.
10. BAHAGRASS HOUSING PVT. LTD.
11. COLLETIA HOUSING PVT. LTD.
12. KUDZO GRIHO PVT. LTD.
13. AVARUM BUILDERS PVT. LTD.
14. THYONE AGRI PRODUCTS PVT. LTD.
15. FENNCOUP BUILDERS PVT. LTD.
16. REDGRASS HOUSING PVT. LTD.
17. RVANNUS REALTY PVT. LTD.
18. SOURSOP REALTY PLUS PVT. LTD.
19. BALLOTA HOUSING PVT. LTD.
20. MADGINGRASS HOUSING PVT. LTD.
21. ANTHERIUS FILTERS PVT. LTD.
22. ANTHERIUS REALITY PVT. LTD.
23. MONTIPORA BUILDERS PVT. LTD.
24. THYONE TRAVELS PVT. LTD.
25. PHOEDS COMPUTERS PVT. LTD.
26. THYONE BOOKS & PERIODICALS PVT. LTD.
27. THYONE AGRO MARKETING PVT. LTD.
28. THYONE INTERIOR DECORATORS PVT. LTD.
29. PHOBOS AGRI COMMERCIAL PVT. LTD.
30. THYONE IMAGE & GRAPHICS PVT. LTD.
31. THYONE IT SOLUTIONS PVT. LTD.
32. PHOEDS BOOKS AND PERIODICALS PVT. LTD.
33. LETMUS REALTY PVT. LTD.
34. PHOEDS RETAIL PVT. LTD.
35. PHOEDS IT SOLUTIONS PVT. LTD.
36. RAS HERBAL PRODUCTS PVT. LTD.
37. DEMOS TRAVELS PVT. LTD.
38. DEMOS COMPUTERS PVT. LTD.
39. DEMOS HERBAL PRODUCTS PVT. LTD.
40. THYONE COMPUTERS PVT. LTD.
41. EDJARI INFRACON PVT. LTD.
42. ETAKA REAL ESTATE PVT. LTD.
43. EKARAJ BUILDCON PVT. LTD.
44. PITAYA REALTY PVT. LTD.
45. FOUNTAINGRASS BUILDERS PVT. LTD.
46. SVIDEBILL REALTY PVT. LTD.
47. VETIVER REALTY PVT. LTD.
48. LEGHVI REAL ESTATE PVT. LTD.
49. ILLUSION DEVELOPERS PVT. LTD.
50. LEGHVI VILLA PVT. LTD.
51. EKARAJ HOUSING PVT. LTD.
52. INTEGRAL PROPERTIES PVT. LTD.
53. EKARAJ PROPERTIES PVT. LTD.
54. EKARAJ REAL ESTATE PVT. LTD.
55. EDISHI TOWER PVT. LTD.
56. EKANAJ BUILDCON PVT. LTD.
57. EDJARI INFRASTRUCTURE PVT. LTD.
58. AYANNA PROJECTS PVT. LTD.
59. ESTHER BUILDCON PVT. LTD.
60. ETAKA HOMES PVT. LTD.
61. AYANNA CONSTRUCTION PVT. LTD.
62. EVANAJ COMPLEX PVT. LTD.
63. ESTHER PROPERTIES PVT. LTD.
64. SRIDONI INFRASTRUCTURE PVT. LTD.
65. SRIDONI REAL ESTATE PVT. LTD.
66. WISHFUL BUILDCON PVT. LTD.
67. STAR PLAZA PVT. LTD.
68. SRIDONI CONCLAVE PVT. LTD.
69. SRIDONI DEVELOPER PVT. LTD.
70. NIVA INFRA PROJECTS PVT. LTD.
71. AYANNA DEVELOPERS PVT. LTD.
72. ETAKA BUILDERS PVT. LTD.
73. ESTHER INFRAPROJECTS PVT. LTD.
74. EVANAJ PROJECTS PVT. LTD.
75. EKDANI INFRACON PVT. LTD.
76. ANUP KUMAR JAYARWAL
77. ANUP KUMAR JAYANTHI
78. SANGITA CHAKRABORTI
79. SUNDAR KUMAR MALI
80. RUPA MONDAL
81. NIRMAL GHOSHWARY
82. JAYANTA ROY
83. SHREYA MUKHOPADHYAY
84. SIBAMOY CHAKRABORTY
85. PRADIPTA KUMAR MAITI
86. TANUSREE MAITI
87. DIPIKA BANERJEE
88. JIBAN KUMAR DE
89. SUBRATA DE
90. DEMOS MANAGEMENT CONSULTANTS PVT. LTD.

SIGNATURE OF OWNERS

CERTIFICATE OF STRUCTURAL ENGINEER :

THIS IS TO CERTIFY THAT THE STRUCTURAL DESIGN AND DRAWING OF BOTH FOUNDATION AND SUPERSTRUCTURE OF THE BUILDING HAS BEEN MADE BY ME CONSIDERING ALL POSSIBLE LOADS INCLUDING THE SEISMIC LOAD AS PER THE NATIONAL BUILDING CODE OF INDIA AND CERTIFIED THAT IT IS SAFE AND STABLE IN ALL RESPECTS.

SIGNATURE OF STRUCTURAL ENGINEER

SIGNATURE OF STRUCTURAL REVIEWER

CERTIFICATE OF ARCHITECT :

I DO HEREBY CERTIFY WITH FULL RESPONSIBILITY THAT THE BUILDING PLAN HAS BEEN DRAWN UP AS PER NATIONAL BUILDING CODE OF INDIA 2005 AS AMENDED FROM TIME TO TIME. THAT THE WIDTH OF THE ABUTTING ROAD CONFORM TO THE WIDTH AS SHOWN IN THE PLAN. THAT THE PLOT IS NOT FILLED UP SWAMP. THE SITE PLAN, LOCATION PLAN AGREES WITH THE SITE. THE PLOT IS DEMARCATED BY BOUNDARY WALLS & MEASUREMENTS TALLY WITH THE RECORD DEED PLAN. THE EXISTING STRUCTURE AS SHOWN FULLY OCCUPIED BY OWNER(S) AS PER OWNER'S INSTRUCTIONS.

ANIRBAN BAKSHI
Architect
Council of Architecture
CA / 2003 / 27292
SIGNATURE OF ARCHITECT

Project :

PROPOSED RE-REVISED ONE NO. G+15 STORIED (TOWER-9) ONE NO. B+G+12 STORIED (TOWER-12) AND NINE NO. (TOWER-3 TO TOWER-11) G+15 STORIED UNDER GROUP RESIDENTIAL BUILDING WITH 5 LAYERED PODIUM PARKING OVER COMMON BASEMENT AT D. H. ROAD, MOUZA - SARMESTARCHAK, J.L. NO. 17, TOUZI NO. 331 & 331 (L), R.S. DAG NOS. 115, 116 & 117, CORRESPONDING TO L.R. DAG NOS. 114, 115 & 116, MOUZA - DALUKPUL, M.L. NO. 70, TOUZI NOS. 1776, R.S.&.R. DAG NOS. 23, 27, 28, 29, 30, 31, 32, 33, 34, 45 & 49, POST OFFICE - PAIJAN HAT, POLICE STATION - SIGNHUPUR, WITHIN KULIDANGA GRAM PANCHAYET, DISTRICT - SOUTH 24 PARGANAS.

Consultant :

M.N Consultants One Design Solutions
1516, Rajdanga Main Road, Kolkata-700107.
Telephone : 033 40165700
Email: mnodds@gmail.com
Web: www.mno-one.com

Drawing Title :

TOWER-10 & 11 : SECTION J-J, NORTH ELEVATION

Scale	Date
1 : 100	16.03.2017

Draft	Checked	Approved
SUSMITA	BISWAJIT	SOMDEB

☐ Design Development ■ Sanction Dwg
☐ Contract Document ☐ Construction Dwg ☐ As Built Dwg

Revision No.	Revision Date
R2	23.01.2019

Drawing No. JKA-SD- 29

North

Job No. 2016-2017/01/JKA

REVISED SANCTIONED PLAN
File No. 428/Sonarpur/Plg/Mncpl

ASSISTANT ENGINEER South 24 Pgs. Z.P.

Chief Engineer South 24 Pgs. Z.P.