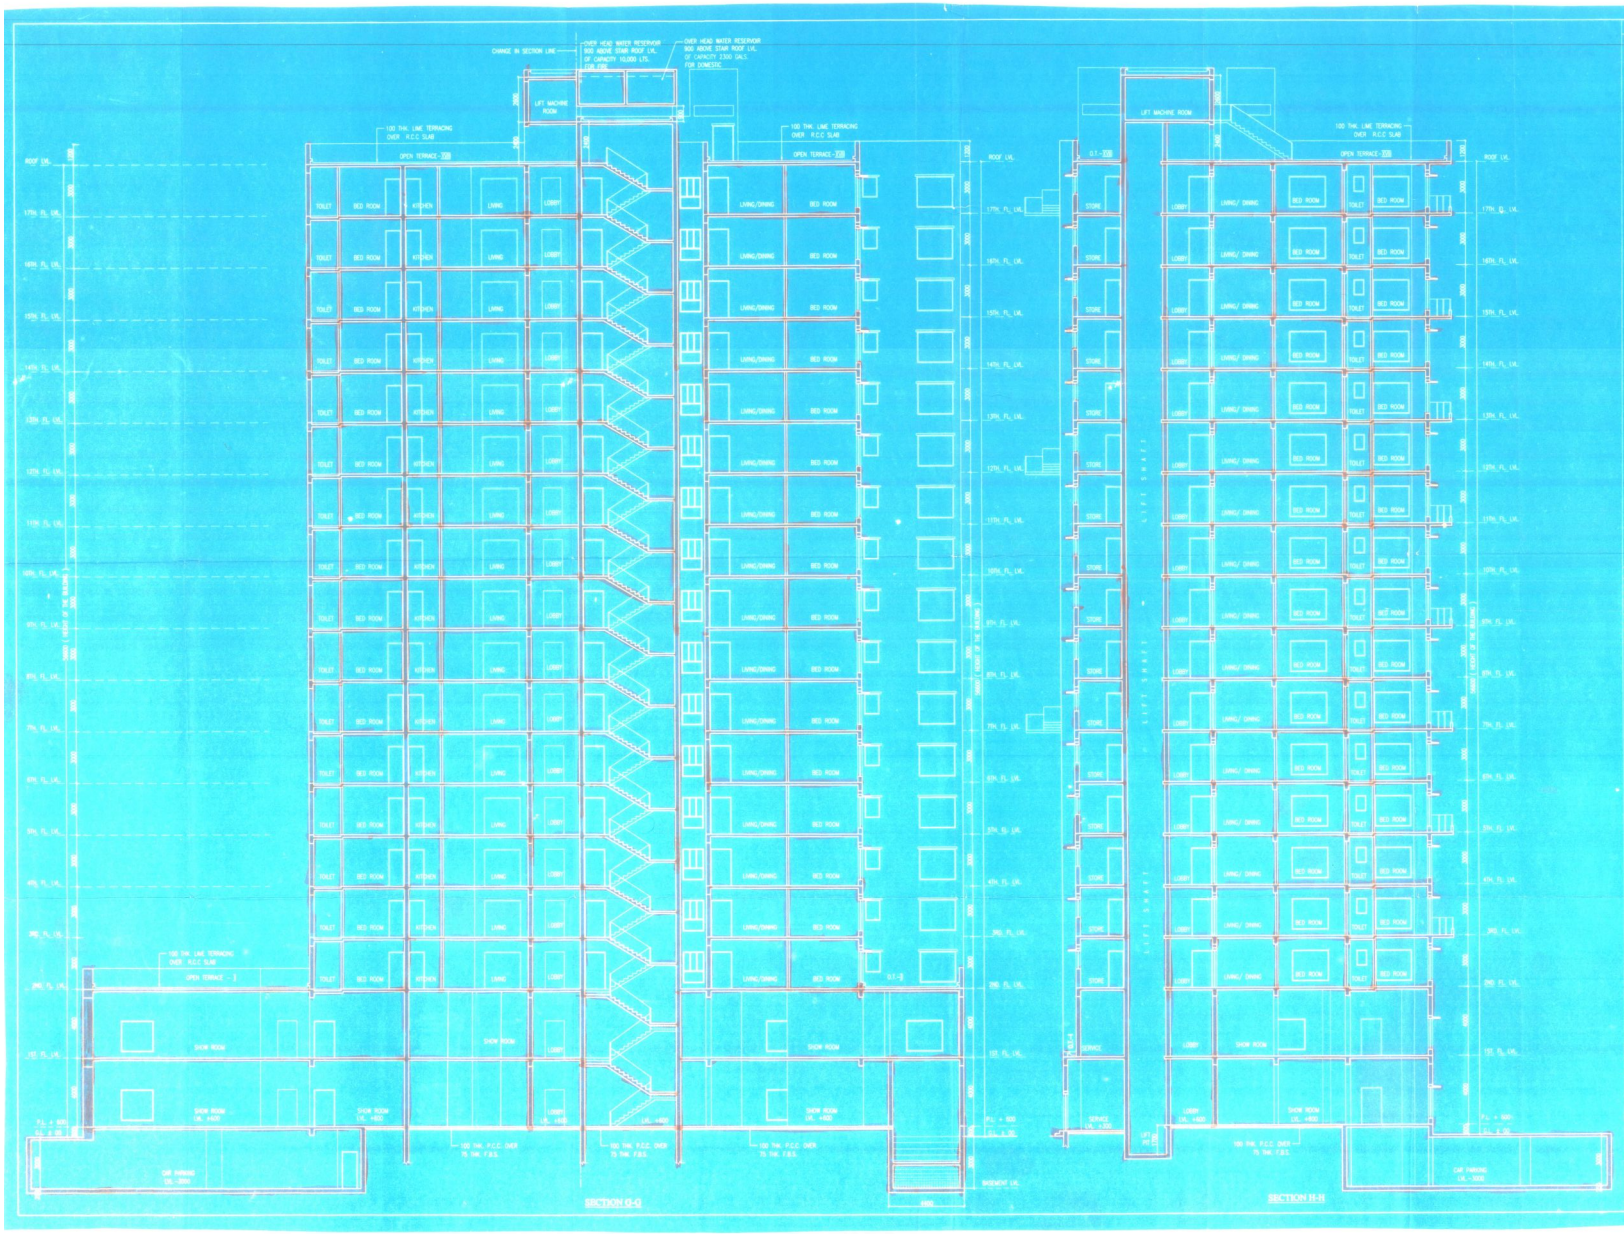

CERTIFICATE OF OWNER.

CERTIFIED THAT I HAVE GONE THROUGH THE BUILDING RULES FOR KAMARHATI MUNICIPALITY AND ALSO UNDER TAKE TO ABIDE BY THOSE RULES DURING AND AFTER CONSTRUCTION OF THE BUILDING

NAME OF OWNER
RASIKA MERCHANDISE (P) LTD.

For Rasika Merchandise Pvt. Ltd.

Director / Authorised Signatory

SIGNATURE OF OWNER.

CERTIFICATE OF STRUCTURAL STABILITY.

WE HERE BY CERTIFIED THAT THE FOUNDATION AND THE SUPERSTRUCTURE OF THE BUILDING PROPOSED FOR CONSTRUCTION ON MOUZA- ARAGHATA KAMARHATI, J.L. NO.-01,R.S. & L.R. DAG NOS.-3942 TO3431, 3941 TO3435, KOL HOL 113370135 TO 38 , 1697 , P.S.-BELGHORIA, PREMISES NO.-38, B.T.ROAD, MUNICIPAL HOLDING NO.-P-16, WARD NO.- 6, HAVE BEEN SO DESIGNED BY US WILL MAKE SUCH FOUNDATION & SUPER STRUCTURE SAFE IN ALL RESPECTS INCLUDING THE CONSIDERATION OF BEARING CAPACITYOF SOIL E.T.C.

Mainak Majumdar
B.E.E., M.I.E. (Ind.)
FIE - 18201 of 1990
STER / NKDA / 157 / 00020

SIGN. OF STRUCTURAL ENGG.

DR. SUJIT KUMAR BOSE
Ph.D., M.C.E (Soil) B.C.E. (Hons)
M.I.G.S
License No:- EM / Geo -Tech /17

SIGN. OF GEO-TECHNICAL ENGG.

JAY PRAKASH BHARAT KUMAR AGRAWAL
B. Sc., B. Arch.
Regd. No. CA / 1984 / 10668
ARCHITECT SL.NO.- 10229

SIGNATURE OF ARCHITECT

TITLE: SECTION G-G & SECTION H-H. BLOCK-2

PROJECT: PROPOSED PLAN OF G+9+~~2TR~~ /G+9+~~2TR~~ /G+9+~~2TR~~ /G+9+~~2TR~~ STORIED RESIDENTIAL BUILDING AT MOUZA-ARAGHATA KAMARHATI, J.L. NO.-01,R.S. & L.R. DAG NOS.-3942 TO3441 3437 TO3435, HAATIAH HOL 113370 1125, 10 38, 1697, P.S.-BELGHORIA, DIST.- NORTH 24 Parganas, PREMISES NO.-38, B.T.ROAD, MUNICIPAL HOLDING NO.- P-16, WARD NO.- 6, UNDER KAMARHATI MUNICIPALITY.

ARCHITECTS: AGRAWAL & AGRAWAL
BARODA KOLKATA

Drawn	Date	Verify	Checked